


GERANIUM ESTATE - STAGE 1 ROAD & DRAINAGE


CARDINIA SHIRE COUNCIL

22 Business Park Drive Notting Hill 3168
A.C.N. 006 550 803
E: consulting@dpmvic.com.au
W: www.dpmvic.com.au
T: (03) 9538 5000

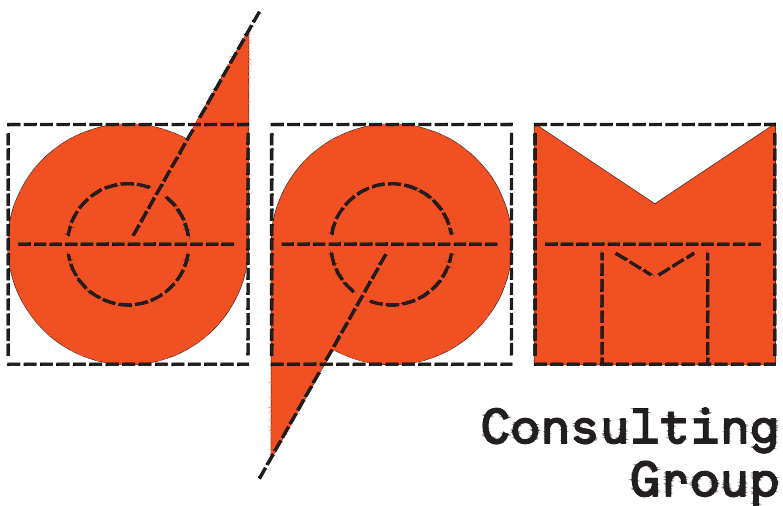


PRINCIPAL
BANRIAR DEVELOPMENTS PTY LTD
C/ DPM CIVIL ENGINEERING PTY. LTD.

DRAWING NO	DETAILS
3257/01/R01	COVER SHEET
3257/01/R02	LAYOUT PLAN & SERVICES OFFSET TABLE
3257/01/R03	INTERSECTION DETAILS - SHEET 1 OF 2
3257/01/R04	INTERSECTION DETAILS - SHEET 2 OF 2
3257/01/R05	TYPICAL CROSS SECTIONS
3257/01/R06	GENERAL NOTES & TYPICAL DETAILS
3257/01/R07	PAVEMENT COMPOSITIONS AND MISCELLANEOUS DETAILS
3257/01/R08	RIX ROAD LONGITUDINAL & CROSS SECTIONS
3257/01/R09	TATJANA WAY LONGITUDINAL SECTIONS
3257/01/R10	TATJANA WAY CROSS SECTIONS
3257/01/R11	SOLANDARI WAY LONGITUDINAL & CROSS SECTIONS
3257/01/R12	DRAINAGE LONGITUDINAL SECTION - SHEET 1 OF 2
3257/01/R13	DRAINAGE LONGITUDINAL SECTIONS & PIT SCHEDULE - SHEET 2 OF 2
3257/01/R14	SIGNAGE AND LINEMARKING

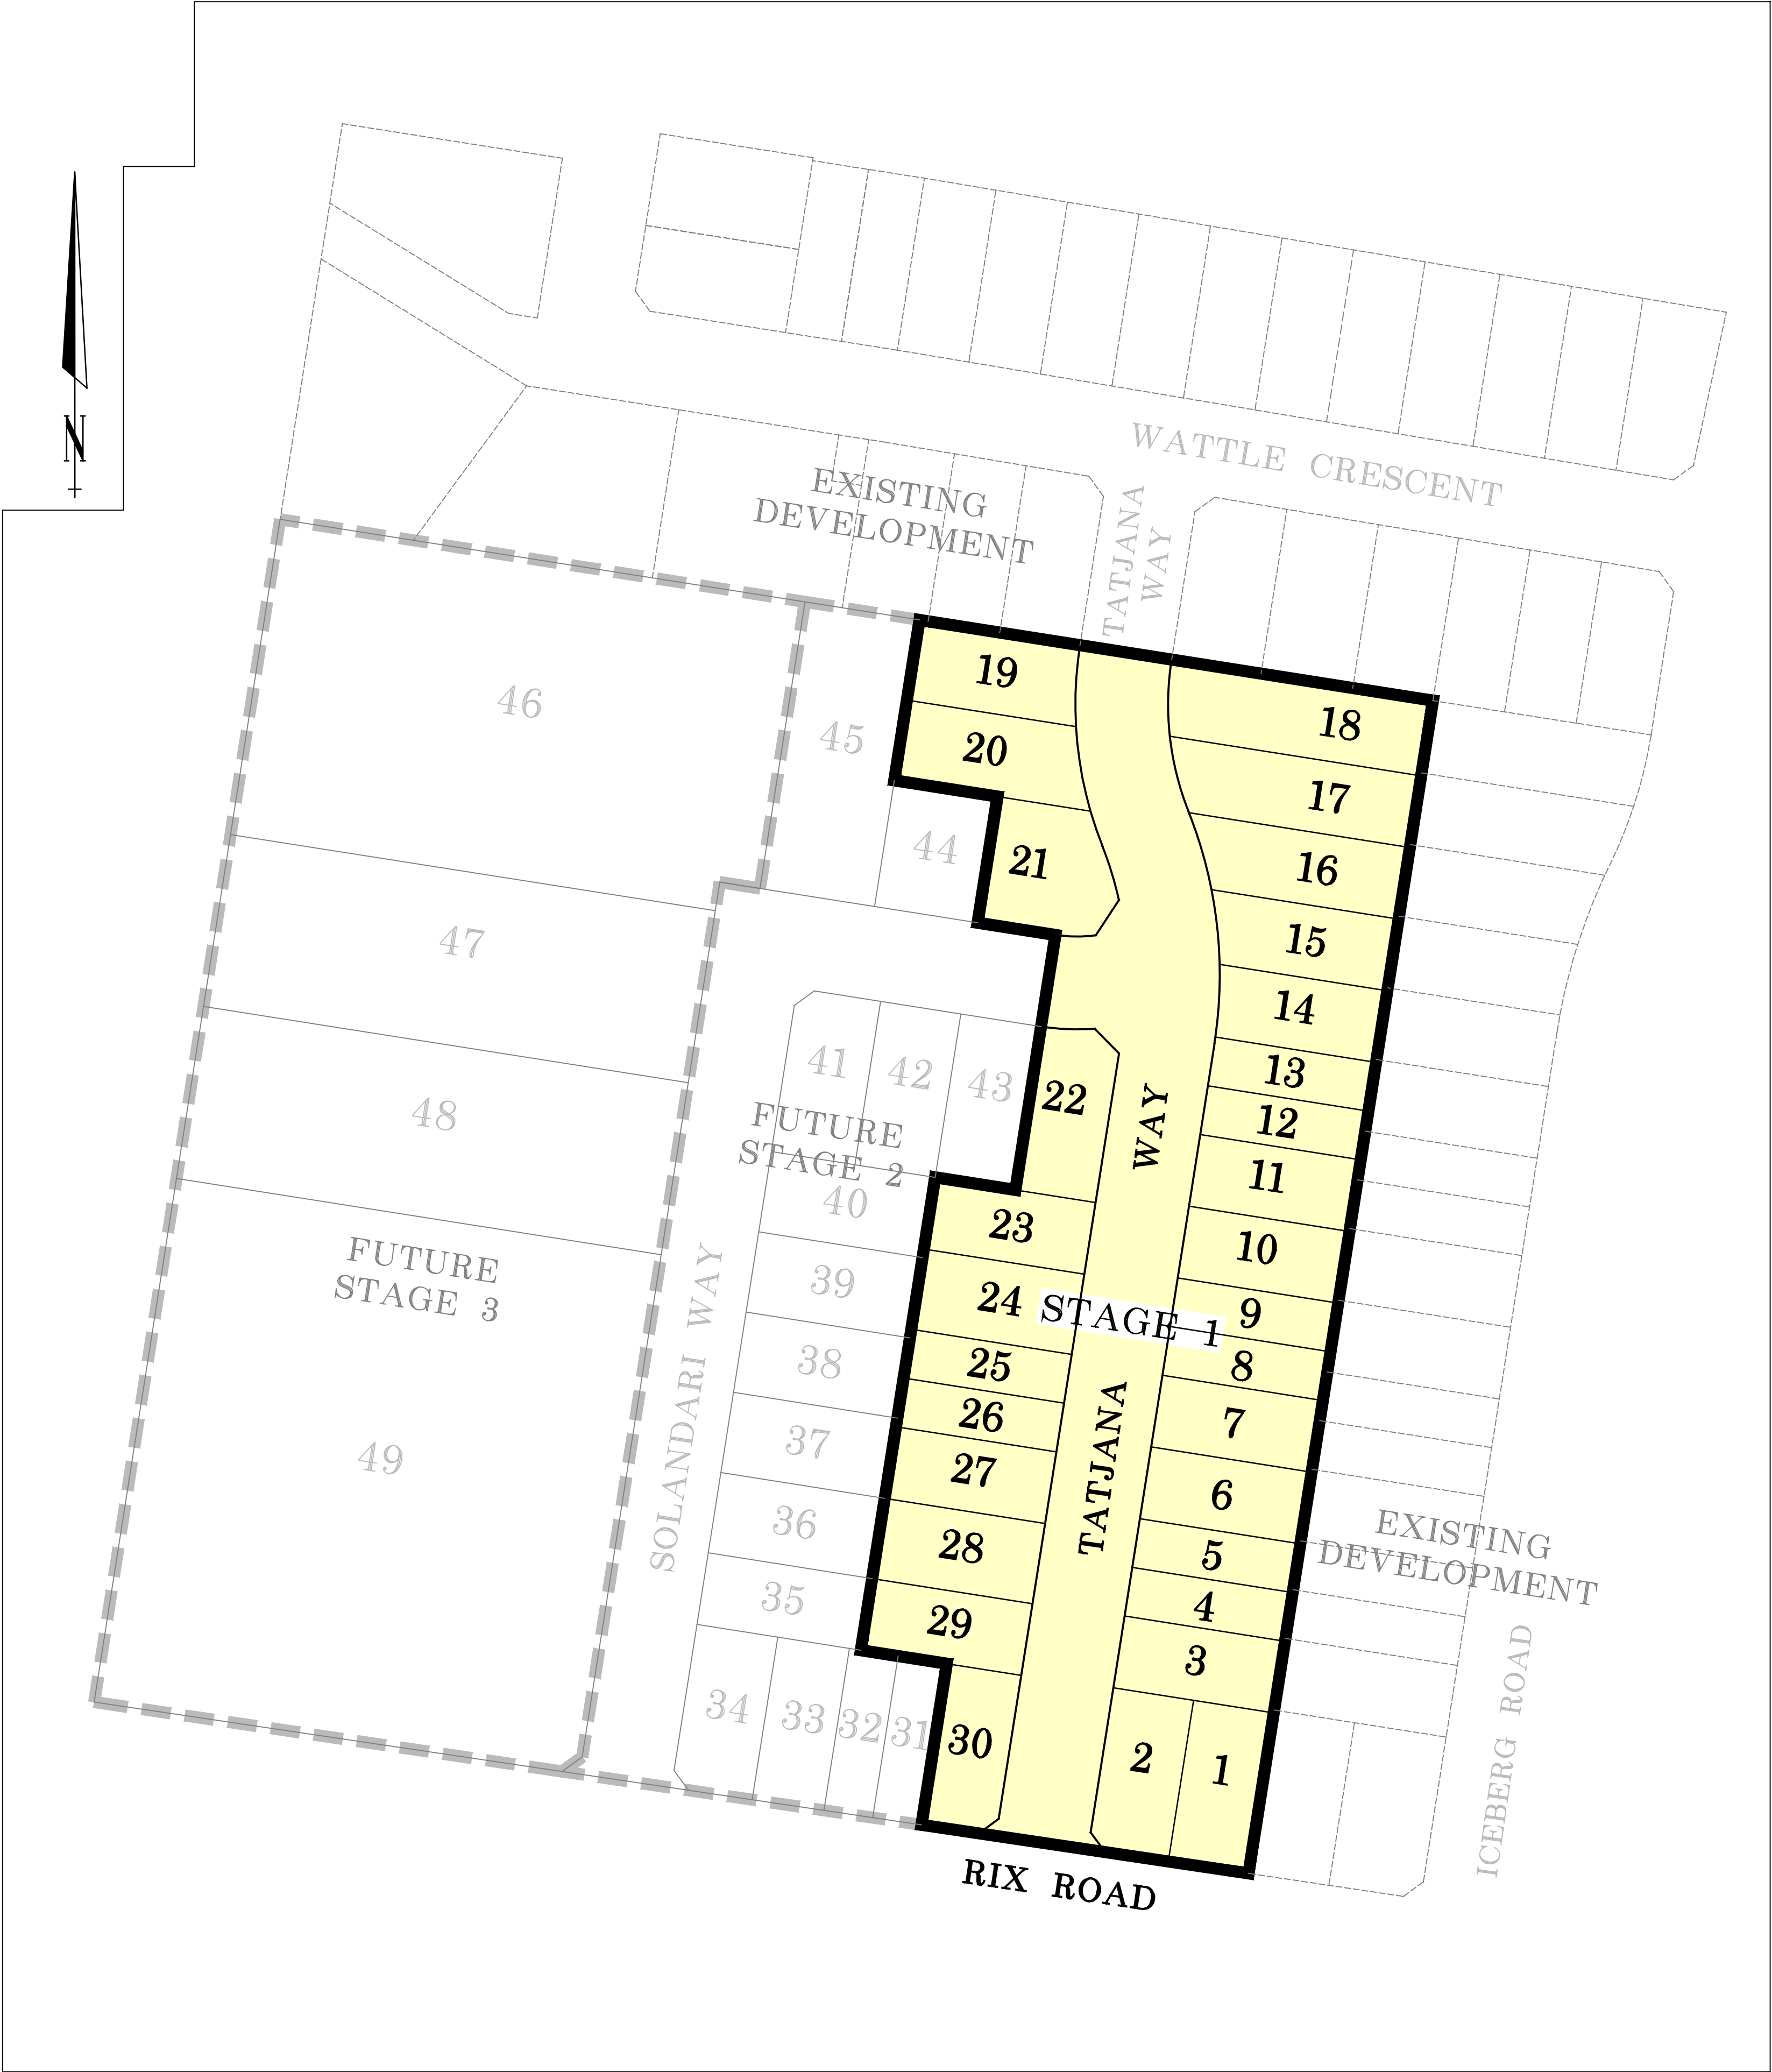

LOCALITY PLAN

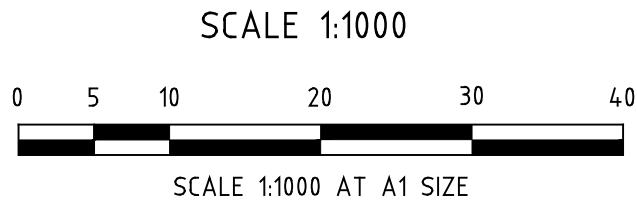

AS CONSTRUCTED

DRAWING No. 3257/01/R01
MELWAYS REF. MAP 214 B5

GERANIUM ESTATE STAGE 1

NOTE:
THIS PLAN SHOWS DETAILS OF WORKS AFFECTING THE NATURAL SURFACE LEVEL OF THE LAND WITHIN THE SUBDIVISION WHICH HAVE BEEN CARRIED OUT OR ARE PROPOSED TO BE CARRIED OUT AS AT THE DATE OF THIS PLAN AND PRIOR TO THE REGISTRATION OF THE PLAN OF SUBDIVISION. IT IS EXPECTED THERE MAY BE A VARIANCE OF ±100MM OF THE LEVELS SHOWN ON THE PLAN.

NOTE:
WHERE THE WORDS 'REG TO ...' OR '1 IN 150 TO ...' APPEAR ALONG AN ALLOTMENT BOUNDARY, THAT LOT IS TO BE GRADED EVENLY BETWEEN THE LEVELS INDICATED UNLESS NOTED OTHERWISE.

'FS' INDICATES THE GRADING IS TO COMMENCE FROM THE FINISHED SURFACE LEVEL AT THE PROPERTY BOUNDARY

'T' INDICATES THE GRADING IS TO COMMENCE FROM THE TOP OR TOE LEVEL OF ANY BATTER AT THE FRONT OF THE PROPERTY

'R' INDICATES THE GRADING IS TO COMMENCE FROM A RIDGE LEVEL WHICH IS TO BE FORMED AT THE OFFSET INDICATED

ALL OTHER ALLOTMENTS REQUIRE NO REGRADING UNLESS DIRECTED IN WRITING BY THE SUPERINTENDENT.

DRIVEWAY CROSSINGS ARE SHOWN INDICATIVELY ON THESE PLANS. THEY ARE TO BE CONSTRUCTED IN ACCORDANCE WITH EDMC S01 AND S02.

PEDESTRIAN CROSSINGS ARE SHOWN INDICATIVELY ON THESE PLANS. THEY ARE TO BE CONSIDERED IN ACCORDANCE WITH EDMC 403.

LEGEND:

- NATIVE VEGETATION PROTECTION AREA AS SHOWN IN THE OFFICER NATIVE VEGETATION PRECINCT PLAN
- NATIVE VEGETATION PROTECTION AREA AS MAPPED BY NATURE ADVISORY
- 30m BUFFER FROM NATIVE VEGETATION TO BE PROTECTED AND RETAINED APPLIES TO THE RELEVANT LOT(S) THAT CONTAIN THE NATIVE VEGETATION
- TREES TO BE REMOVED WITHIN THE NORTHERN VERGE OF RIX ROAD AS PART OF THE STAGE 1 WORKS
- TREES TO BE REMOVED WITHIN 228-236 RIX ROAD PRIOR TO SUBDIVISION WORKS


- LOT FALL ACROSS EACH LOT IS TO BE AT A MINIMUM OF 1 IN 150 TO THE LOWEST POINT OF THE LOT
- OVERALND FLOW PATH

TACTILE GROUND SURFACE INDICATORS (TGS) BOTH DIRECTIONAL AND WARNING TO BE INSTALLED AT PRAM CROSSING LOCATIONS IN ACCORDANCE WITH AS1428.4 AND DDA COMPLIANCE

BEWARE OF EXISTING SERVICES. SERVICES SHOWN ON THIS DRAWING ARE INDICATIVE ONLY. THE CONTRACTOR SHALL BE RESPONSIBLE FOR DETERMINING THE LOCATION OF ALL SERVICES PRIOR TO THE COMMENCEMENT OF ANY EXCAVATION, AND SHALL PROTECT THESE AT ALL TIMES.

DISCLAIMER:
THESE DRAWINGS ARE TO BE USED ONLY FOR THE PURPOSE FOR WHICH THEY WERE INTENDED FOR. NO RESPONSIBILITY WILL BE BORNE BY THE ENGINEERING CONSULTANT SHOULD THESE DRAWINGS BE USED FOR ANY OTHER PURPOSE.

NOTE:
ALL WORKS TO BE CARRIED OUT IN ACCORDANCE WITH THE CURRENT CARDINIA SHIRE COUNCIL SPECIFICATIONS AND STANDARD DRAWINGS AND TO THE SATISFACTION OF THE CONSTRUCTION AND ASSET PROTECTION TEAM

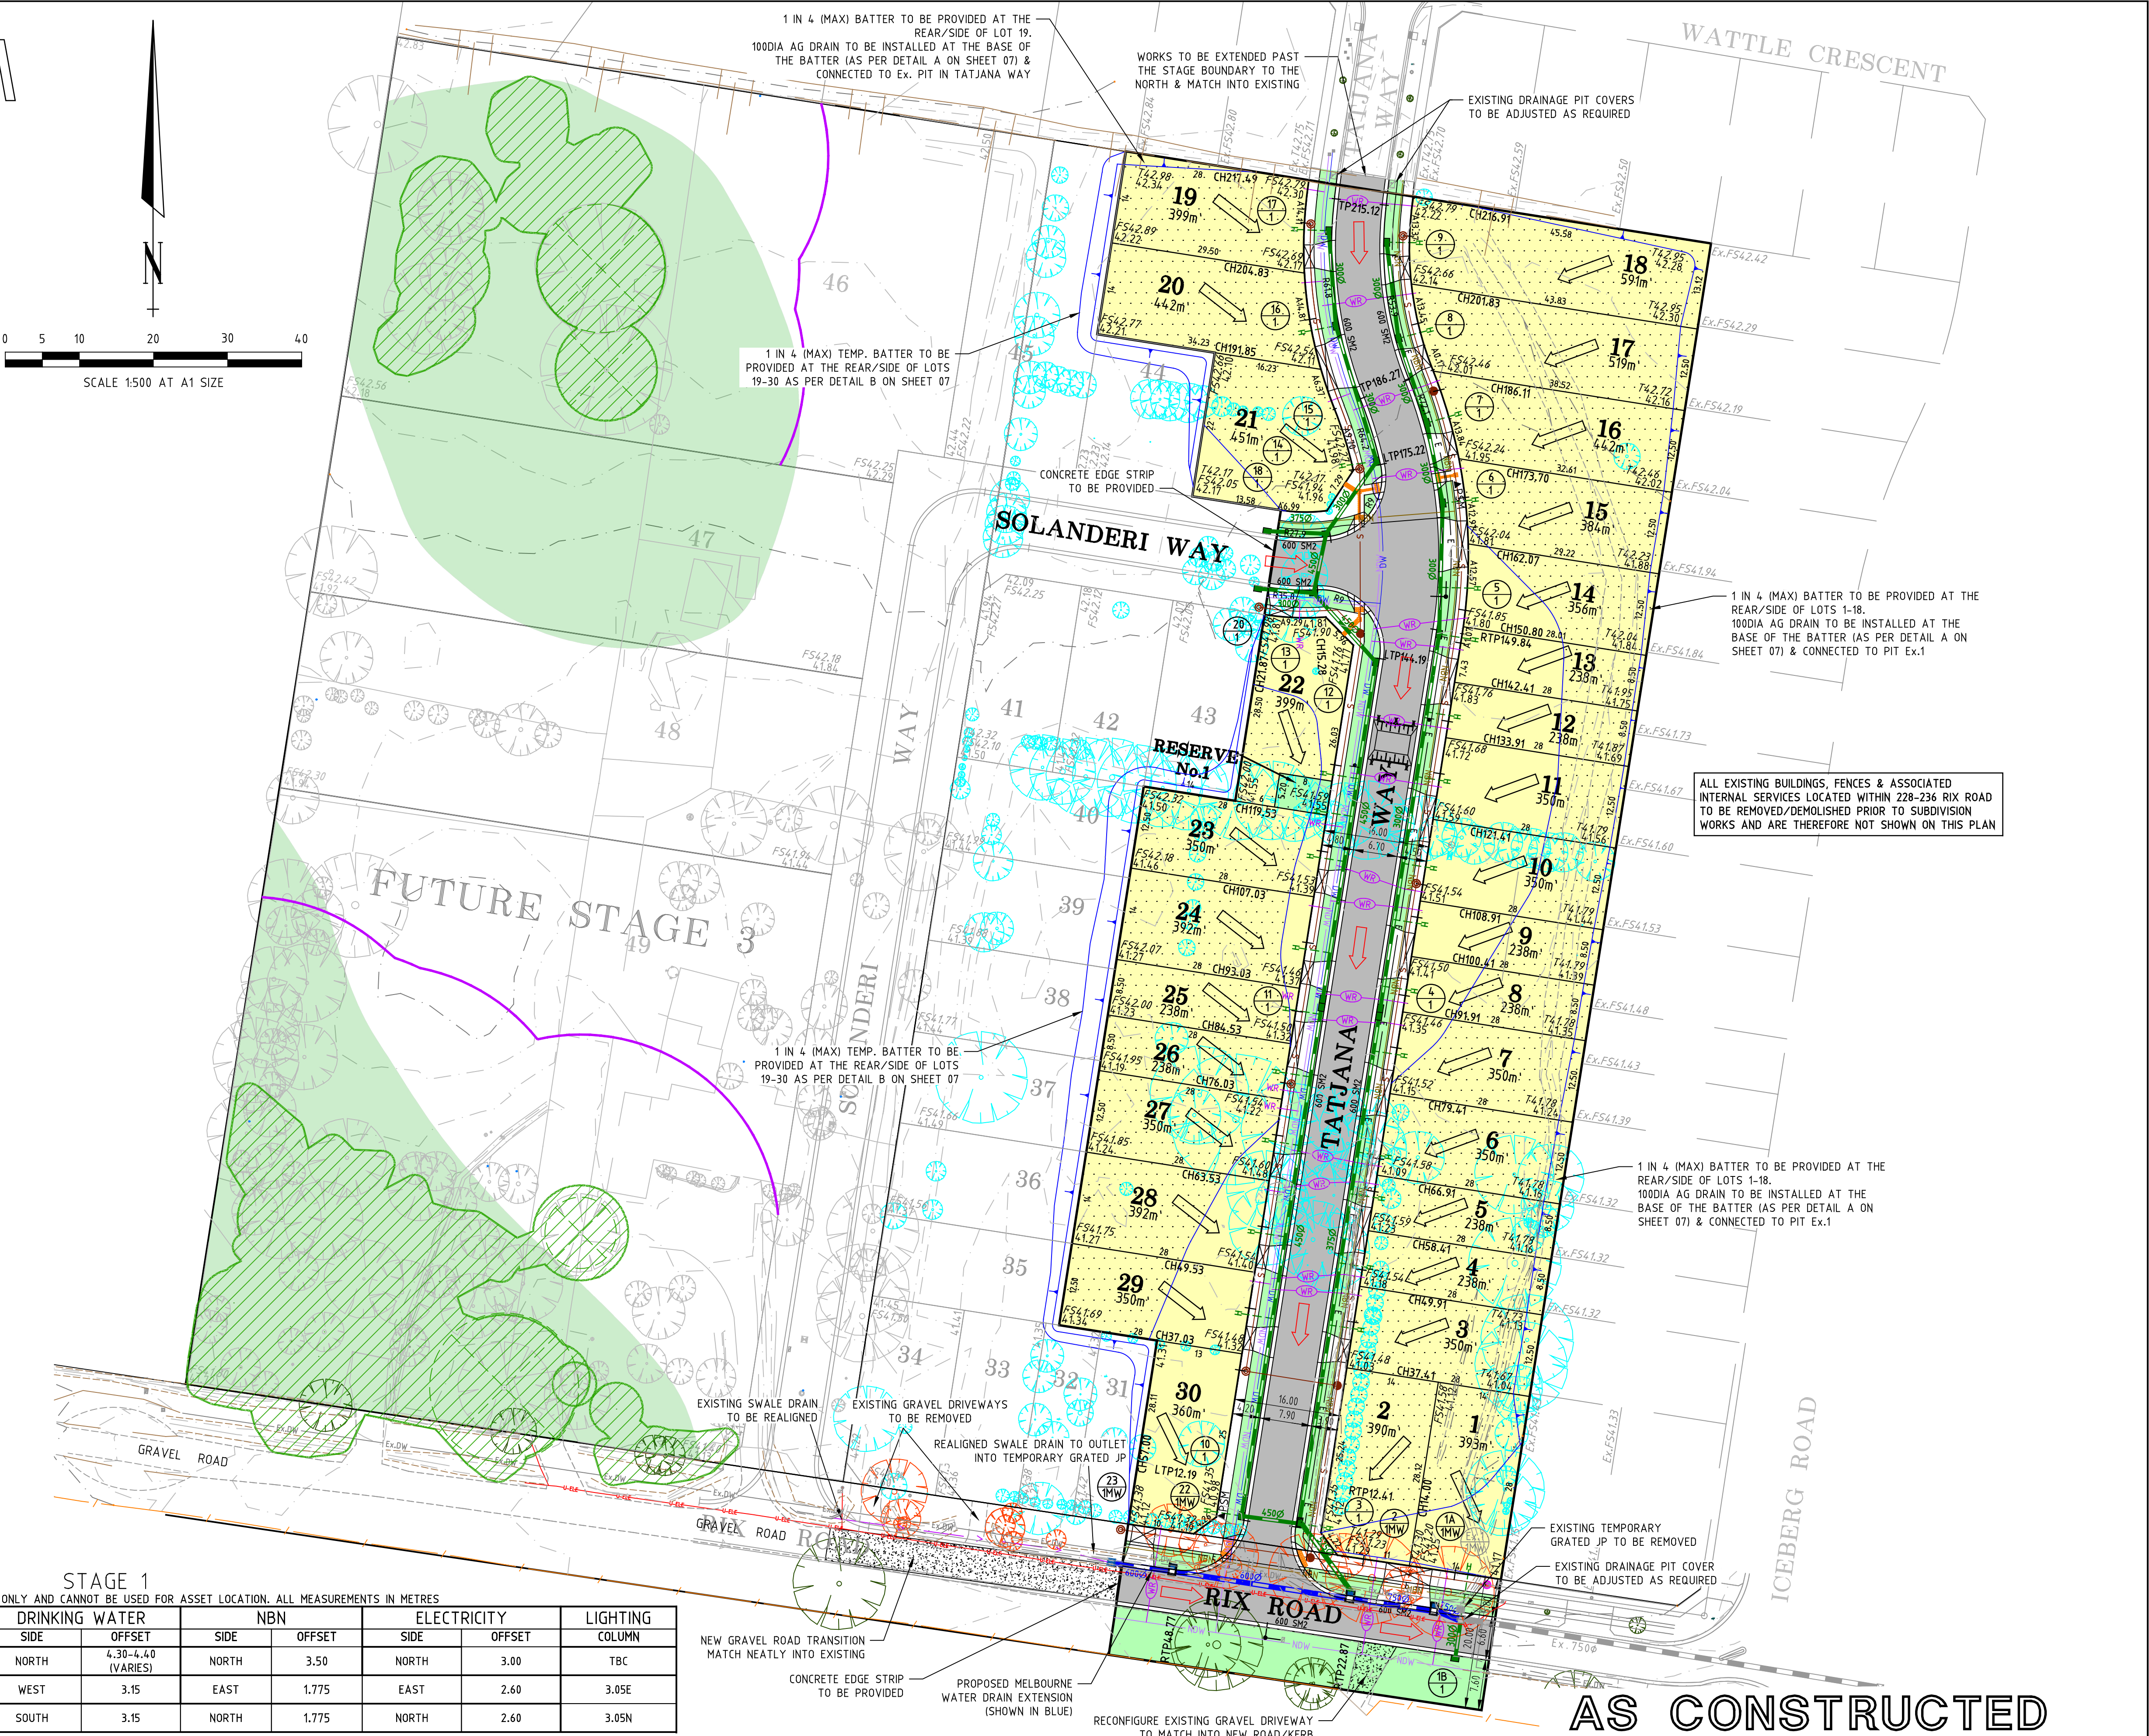

STAGE 1									
NOTE: THIS TABLE IS FOR DESIGN PURPOSES ONLY AND CANNOT BE USED FOR ASSET LOCATION. ALL MEASUREMENTS IN METRES									
ROAD	STREET NAME	NON DRINKING WATER		DRINKING WATER		NBN		ELECTRICITY	
		SIDE	OFFSET	SIDE	OFFSET	SIDE	OFFSET	SIDE	OFFSET
20m ROAD (ULTIMATE)	RIX ROAD	SOUTH	4.95-7.10 (VARIES)	NORTH	4.30-4.40 (VARIES)	NORTH	3.50	NORTH	3.00
16m ROAD	TATJANA WAY	WEST	2.65	WEST	3.15	EAST	1.775	EAST	2.60
16m ROAD	SOLANDERI WAY	SOUTH	2.65	SOUTH	3.15	NORTH	1.775	NORTH	2.60

LEGEND									
	GAS MAIN		HOUSE DRAIN PROPOSED/EX.		CHAINS AND TANGENT POINTS		EXISTING SURFACE LEVEL		EXISTING SURFACE LEVEL
	WATER MAIN		PROPERTY INLET, DRAINAGE PITS		FINISHED LEVEL (TITLE BOUNDARY)		DESIGN TOP/TOE OF BATTER LEVEL		DESIGN PAVEMENT LEVEL
	RECYCLED WATER MAIN		EX./FUT. INLET, DRAINAGE PITS		PROPOSED CONTOUR LINE & LEVEL		EXISTING CONTOUR LINE & LEVEL		FILLING IN EXCESS OF 200mm
	ELECTRICITY CABLE		DRAINAGE PIT STAGE/NUMBER		CATCH DRAIN AND INVERT LEVEL		EX. BATTER		PROP. BATTER
	TELECOMMUNICATIONS CABLE		SEWER LINE AND STRUCTURES		STREET SIGN				
	WATER CONDUIT		EX./FUT. KERB AND CHANNEL						
	GAS CONDUIT		EX./FUT. KERB AND CHANNEL						
	RECYCLED WATER CONDUIT		KERB TO BE REMOVED OFFSITE						
	COMBINED SERVICES CONDUIT								
	T.B.M.								
	P.S.M.								



22 Business Park Drive
Notting Hill VIC 3168
A.C.N. 006 550 803
E: consulting@dpmvic.com.au
W: www.dpmvic.com.au
T: (03) 9538 5000




DRAWN: J.DEMERTZIDIS
DESIGNED: J.DEMERTZIDIS
CHECKED: S.MAKARAS
AUTHORISED: M.COLE
PE REG NO: PE1124072
DATE: 06/02/2025

AUTHORITY: CARDINIA SHIRE COUNCIL
PROJECT: GERANIUM ESTATE - STAGE 1
DETAILS: ROAD & DRAINAGE
LAYOUT PLAN & SERVICES OFFSET TABLE

SCALE 1:500
LEVEL DATUM AHD
SHEET 02 OF 14
DRAWING No. 3257/01/R02
REV. AC1

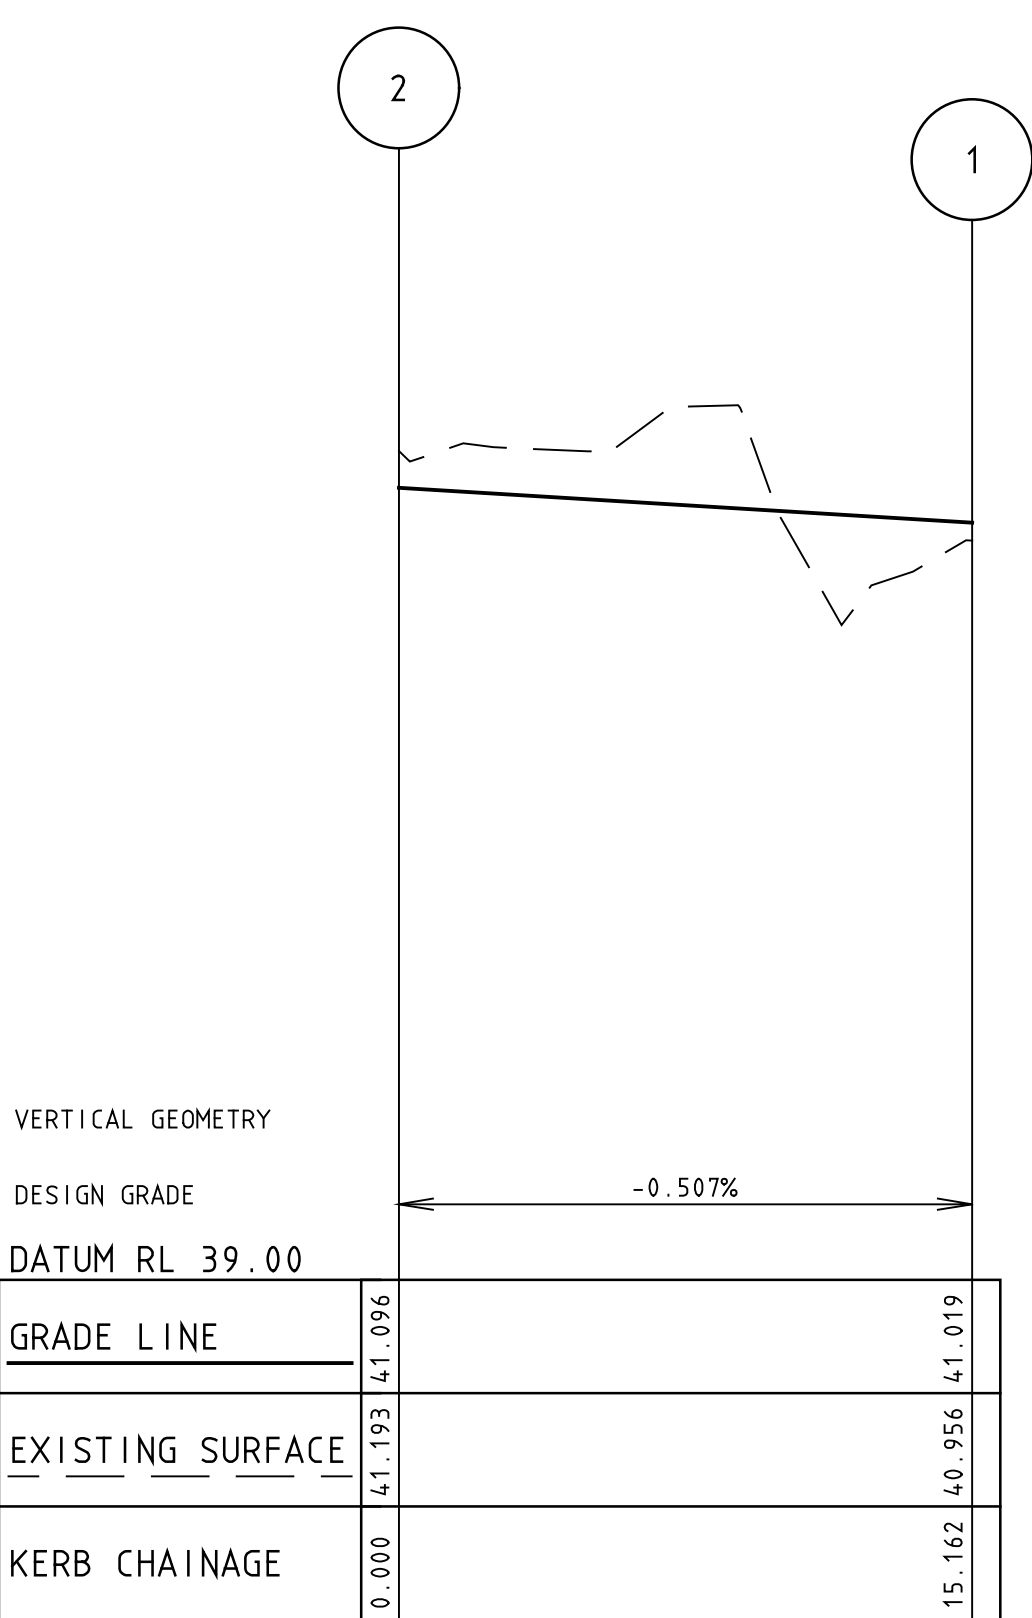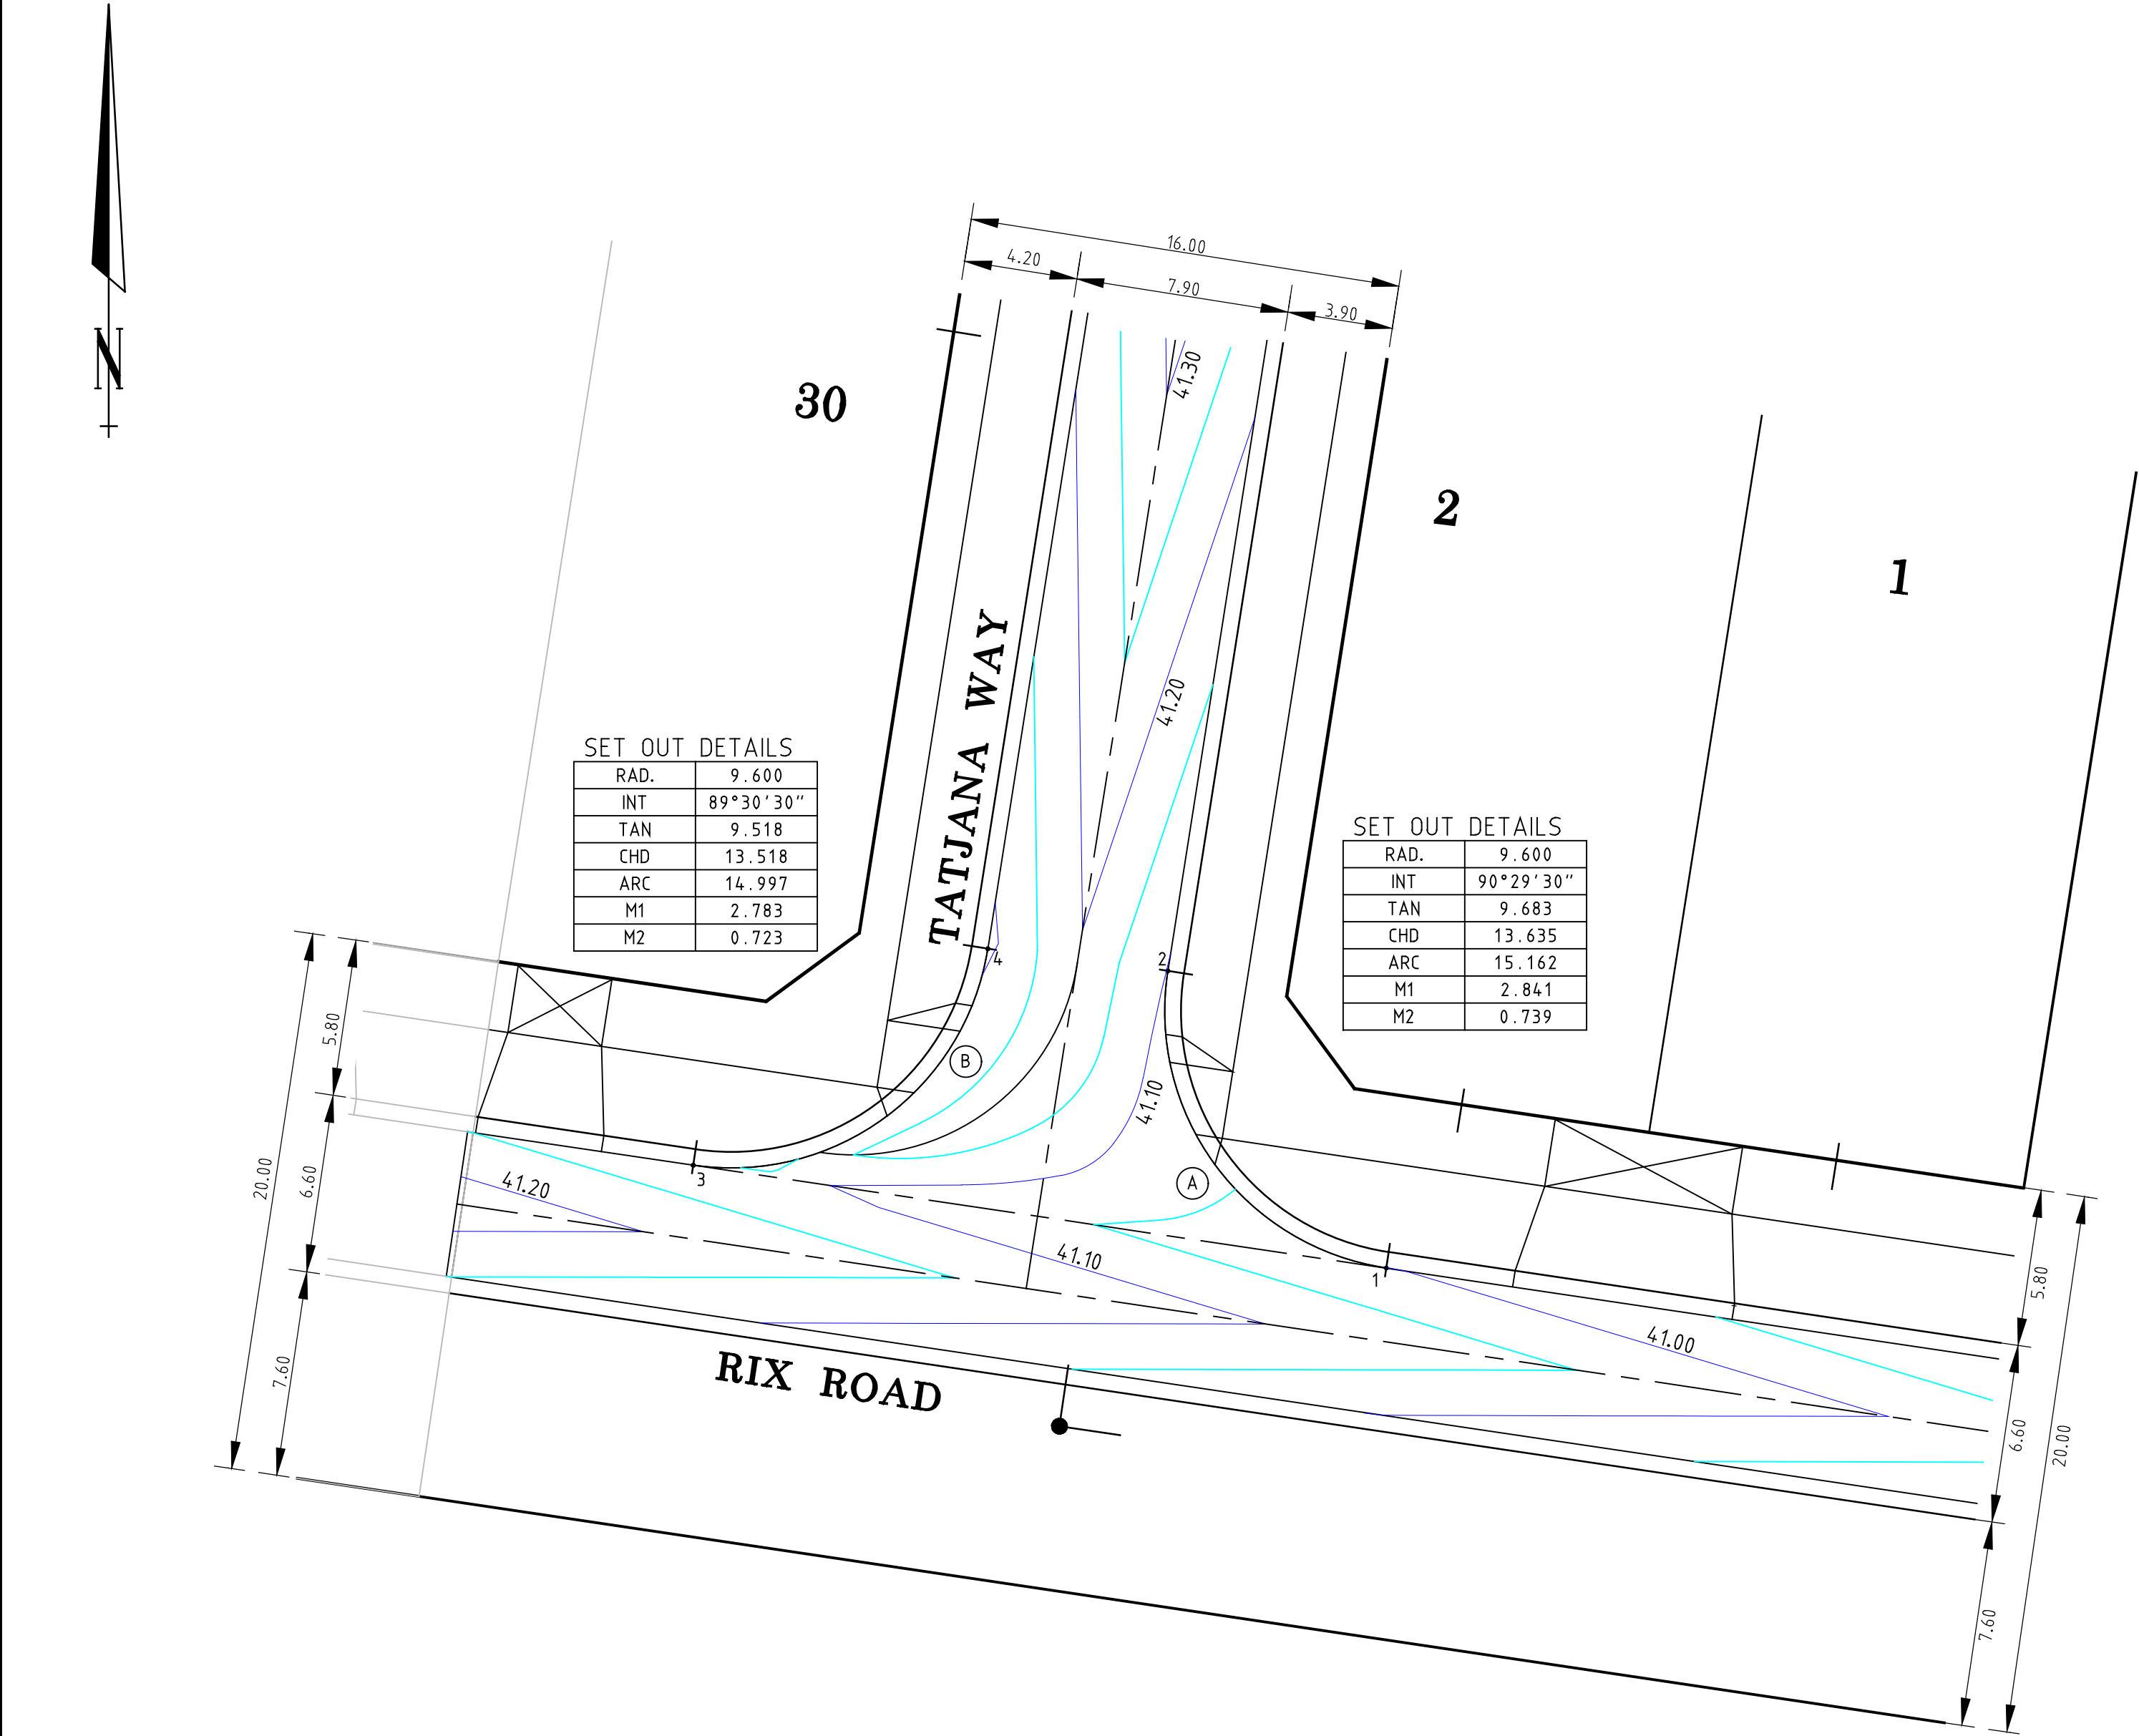


KERB LIP A
Horizontal scale 1:200
Vertical scale 1:20

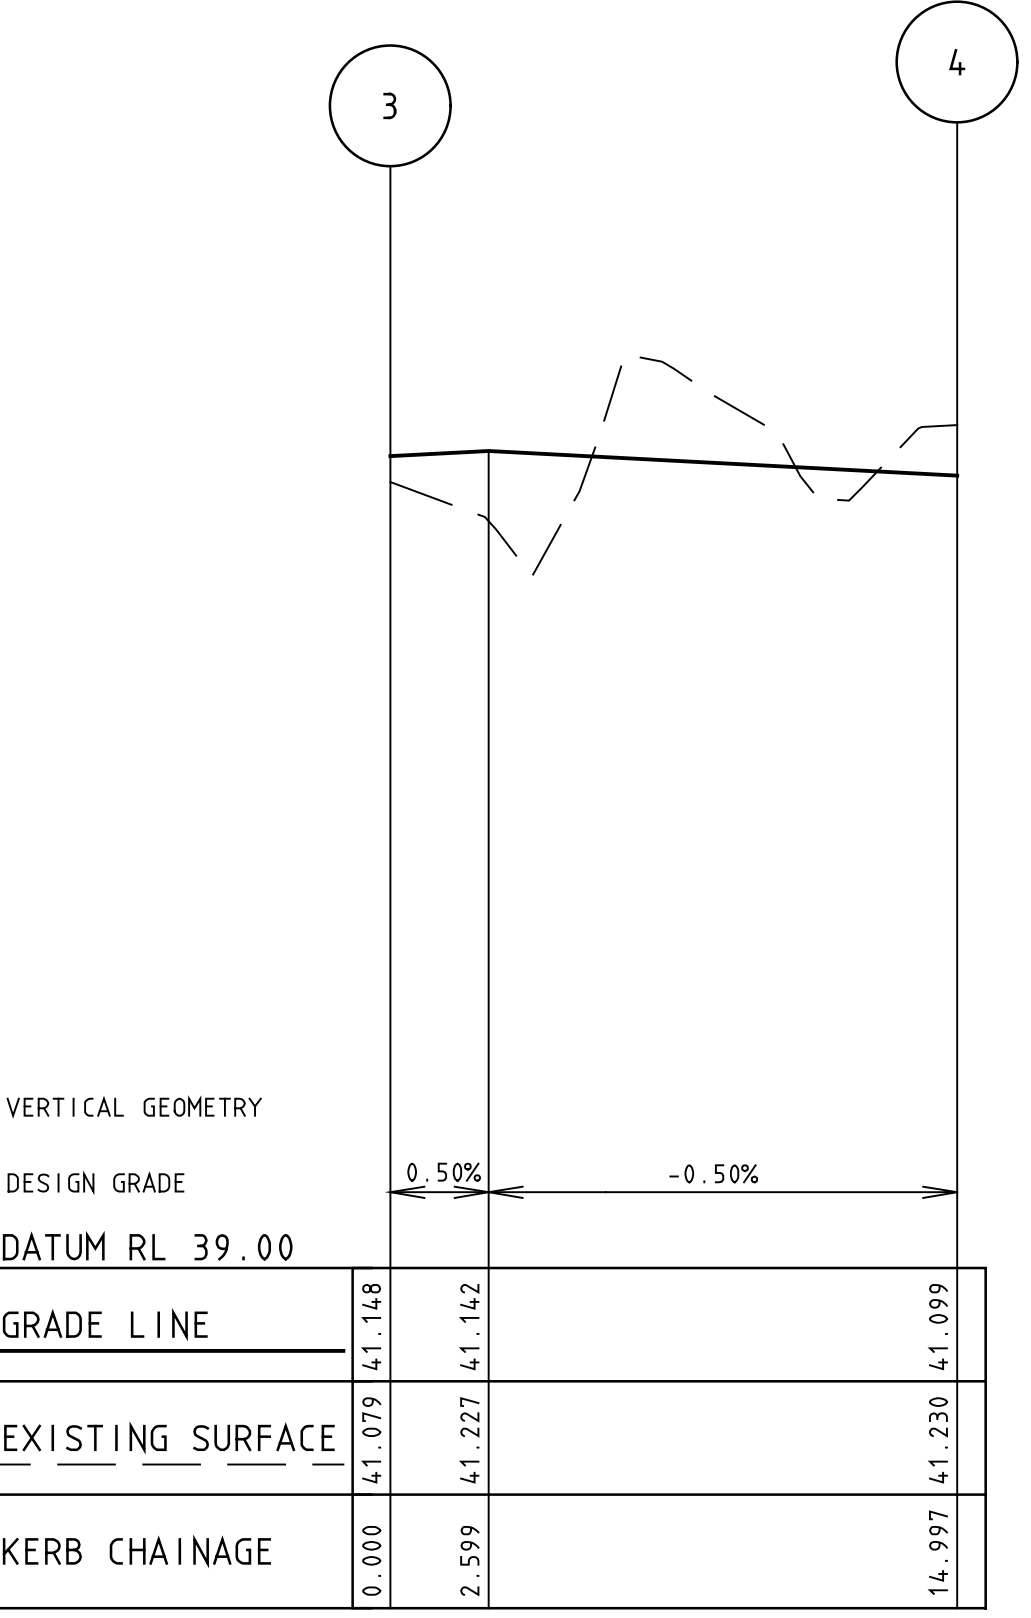

KERB LIP B
Horizontal scale 1:200
Vertical scale 1:20

POINT SET OUT SCHEDULE			
POINT No.	EASTING	NORTHING	R.L.
1	358104.20	5785727.11	41.019
2	358096.13	5785738.10	41.096
3	358078.58	5785730.92	41.148
4	358089.48	5785738.92	41.099

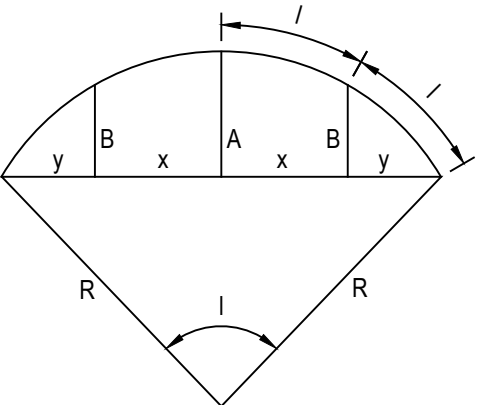

LIP PROFILE SETOUT

SETOUT DETAILS

AS CONSTRUCTED

LEGEND			
	GAS MAIN		HOUSE DRAIN PROPOSED/EX.
	WATER MAIN		PROPERTY INLET, DRAINAGE PITS
	RECYCLED WATER MAIN		EX./FUT. INLET, DRAINAGE PITS
	ELECTRICITY CABLE		DRAINAGE PIT STAGE/NUMBER
	TELECOMMUNICATIONS CABLE		SEWER LINE AND STRUCTURES
	WATER CONDUIT		EX. SEWER LINE AND STRUCTURES
	GAS CONDUIT		KERB AND CHANNEL
	RECYCLED WATER CONDUIT		EX./FUT. KERB AND CHANNEL
	COMBINED SERVICES CONDUIT		KERB TO BE REMOVED OFFSITE
	T.B.M.		STREET SIGN
	CHAINAGES AND TANGENT POINTS		EXISTING SURFACE LEVEL
	FINISHED LEVEL (TITLE BOUNDARY)		DESIGN TOP/TOE OF BATTER LEVEL
	DESIGN PAVEMENT LEVEL		PROPOSED CONTOUR LINE & LEVEL
	EXISTING CONTOUR LINE & LEVEL		FILLING IN EXCESS OF 200mm
	CATCH DRAIN AND INVERT LEVEL		EX. BATTER
	PROP. BATTER		


22 Business Park Drive
Notting Hill VIC 3168
A.C.N. 006 550 803
E: consulting@dpmvic.com.au
W: www.dpmvic.com.au
T: (03) 9538 5000



DRAWN: J.DEMERTZIDIS
DESIGNED: J.DEMERTZIDIS
CHECKED: S.MAKARAS
AUTHORISED: M.COLE
PE REG NO: PE1124072
DATE: 06/02/2025

AUTHORITY: CARDINIA SHIRE COUNCIL
PROJECT: GERANIUM ESTATE - STAGE 1
ROAD & DRAINAGE
DETAILS: INTERSECTION DETAILS - SHEET 1 OF 2

SCALE 1:200
LEVEL DATUM AHD
SHEET 03 OF 14
DRAWING No. 3257/01/R03
REV. AC1

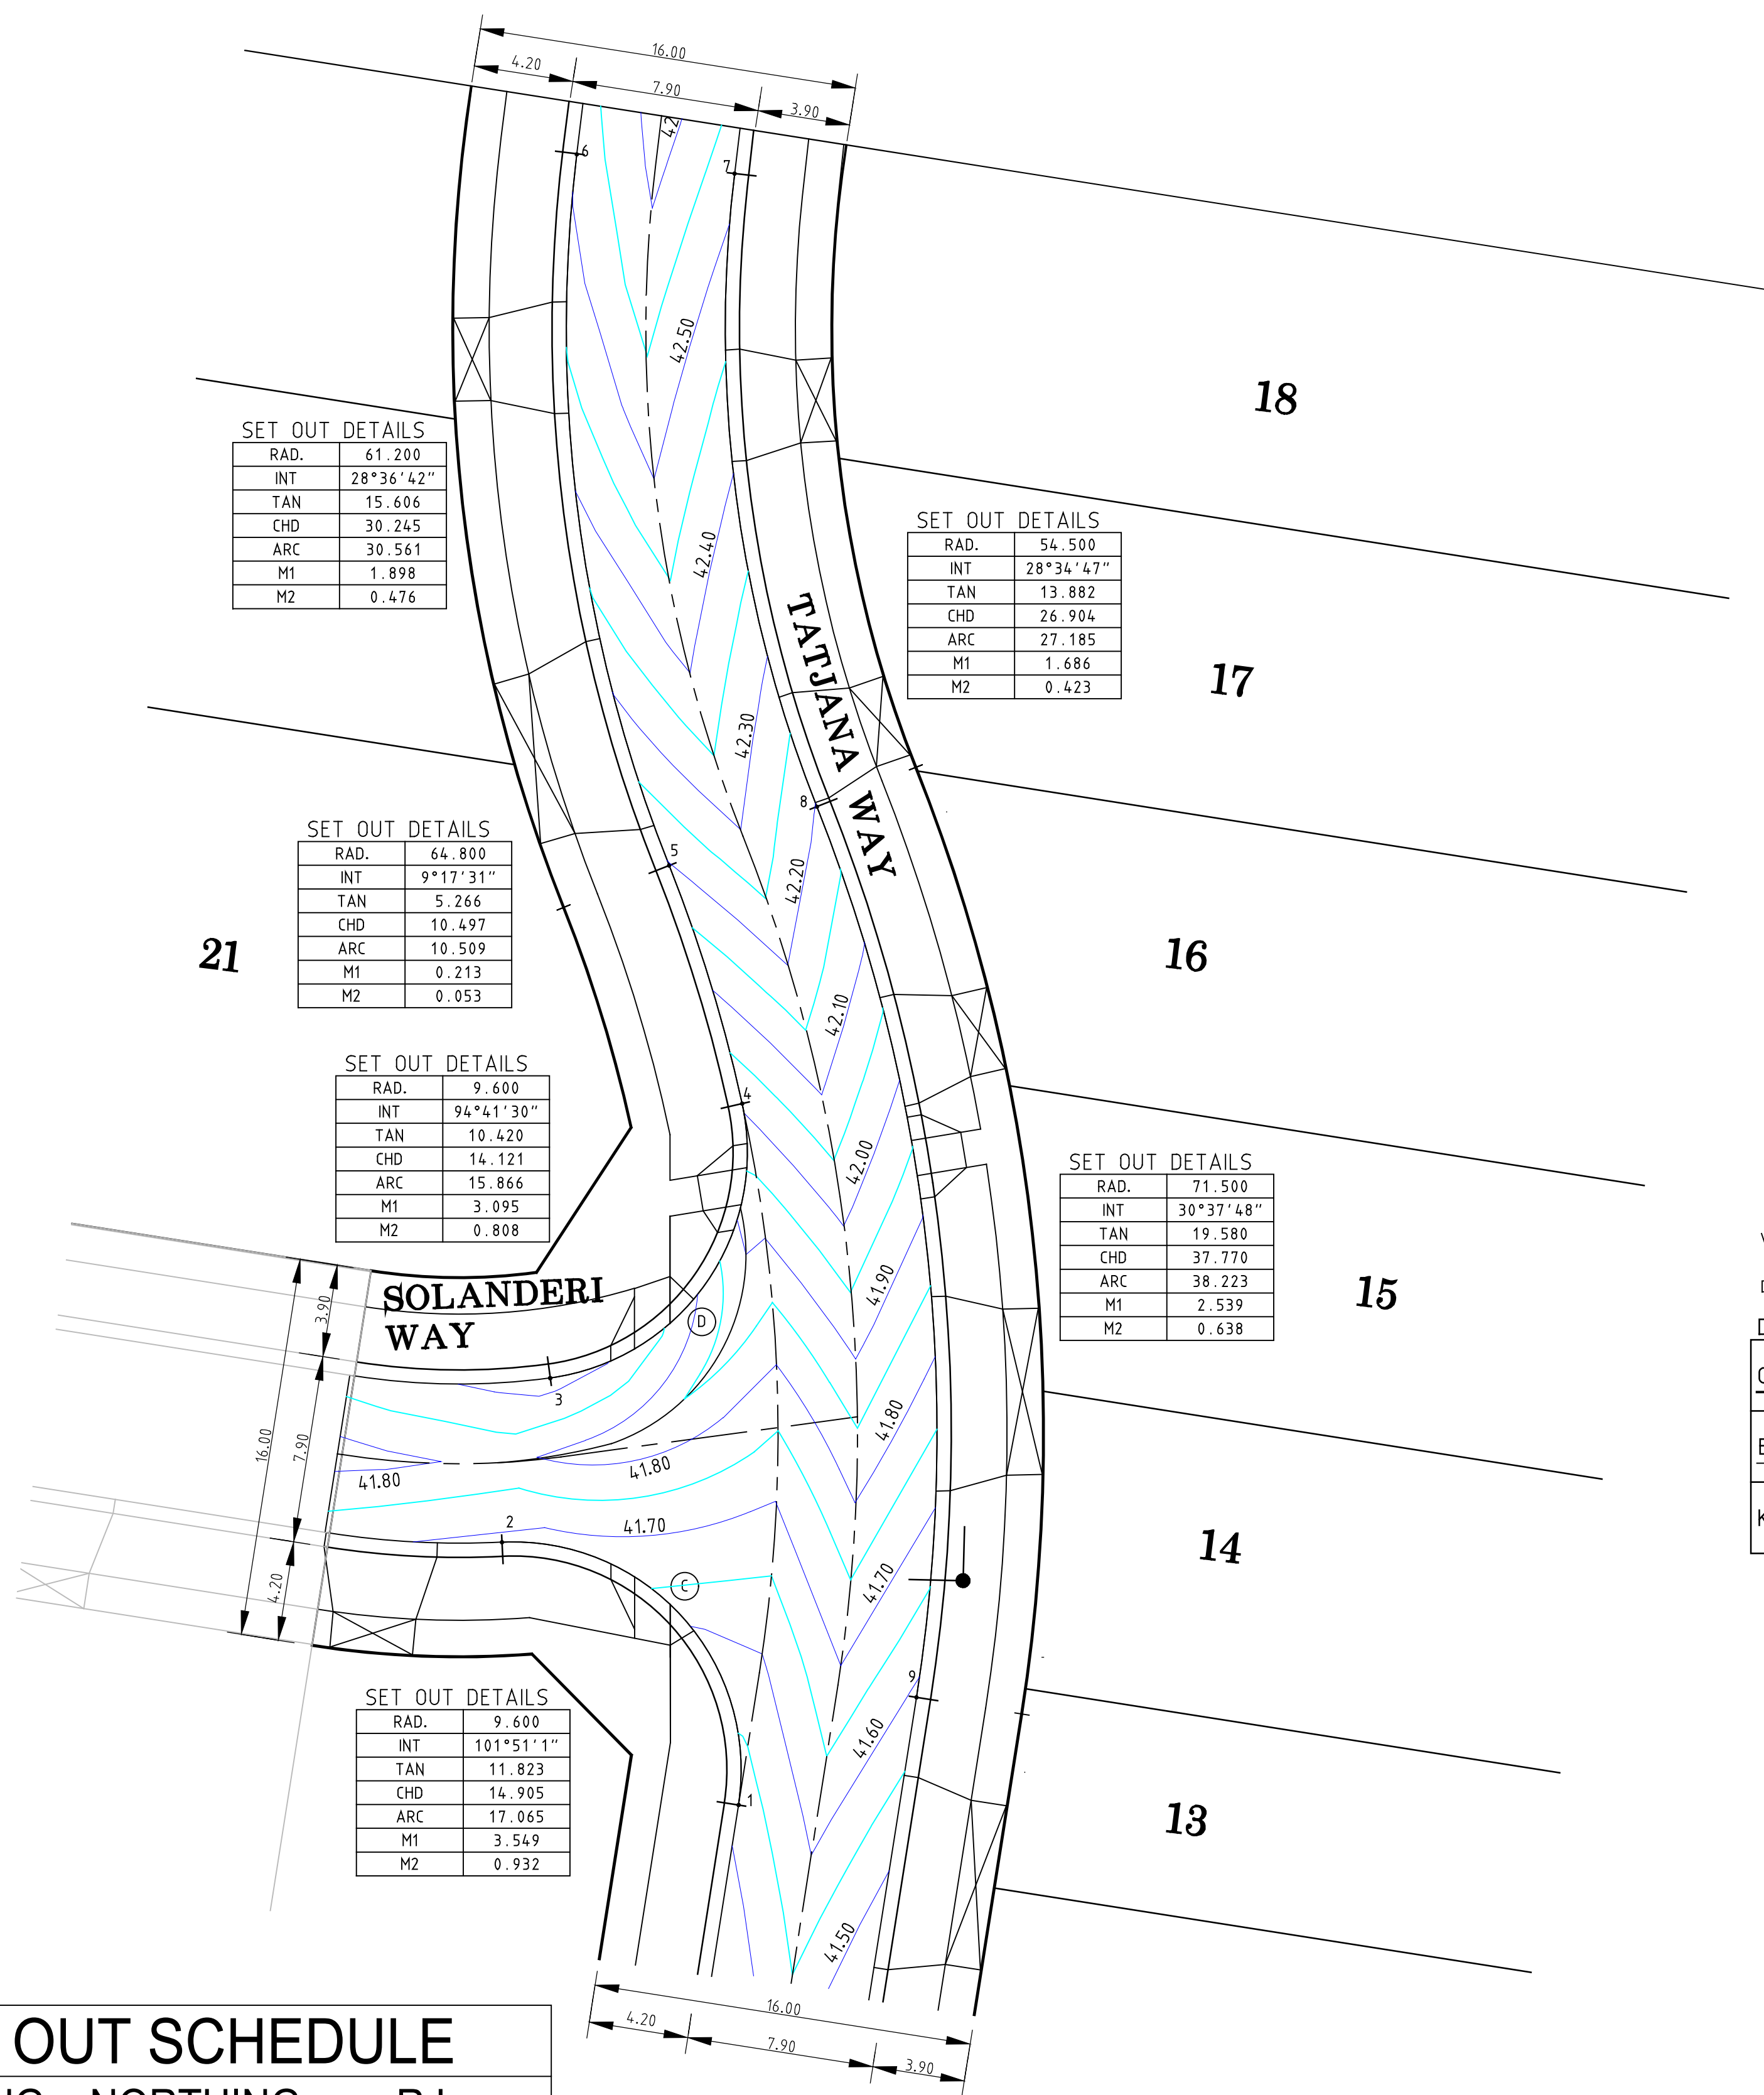

SET OUT DETAILS	
RAD.	61.200
INT	28°36'42"
TAN	15.606
CHD	30.245
ARC	30.561
M1	1.898
M2	0.476

SET OUT DETAILS	
RAD.	54.500
INT	28°34'47"
TAN	13.882
CHD	26.904
ARC	27.185
M1	1.686
M2	0.423

SET OUT DETAILS	
RAD.	64.800
INT	9°17'31"
TAN	5.266
CHD	10.497
ARC	10.509
M1	0.213
M2	0.053



SET OUT DETAILS	
RAD.	9.600
INT	94°41'30"
TAN	10.420
CHD	14.121
ARC	15.866
M1	3.095
M2	0.808

SET OUT DETAILS	
RAD.	71.500
INT	30°37'48"
TAN	19.580
CHD	37.770
ARC	38.223
M1	2.539
M2	0.638

SET OUT DETAILS	
RAD.	9.600
INT	101°51'1"
TAN	11.823
CHD	14.905
ARC	17.065
M1	3.549
M2	0.932


POINT SET OUT SCHEDULE

POINT No.	EASTING	NORTHING	R.L.
1	358109.98	5785869.32	41.519
2	358100.01	5785880.40	41.69
3	358102.04	5785887.31	41.676
4	358110.13	5785898.88	42.008
5	358107.05	5785908.92	42.197
6	358103.16	5785938.89	42.526
7	358109.81	5785938.07	42.526
8	358113.28	5785911.39	42.197
9	358117.47	5785873.86	41.602

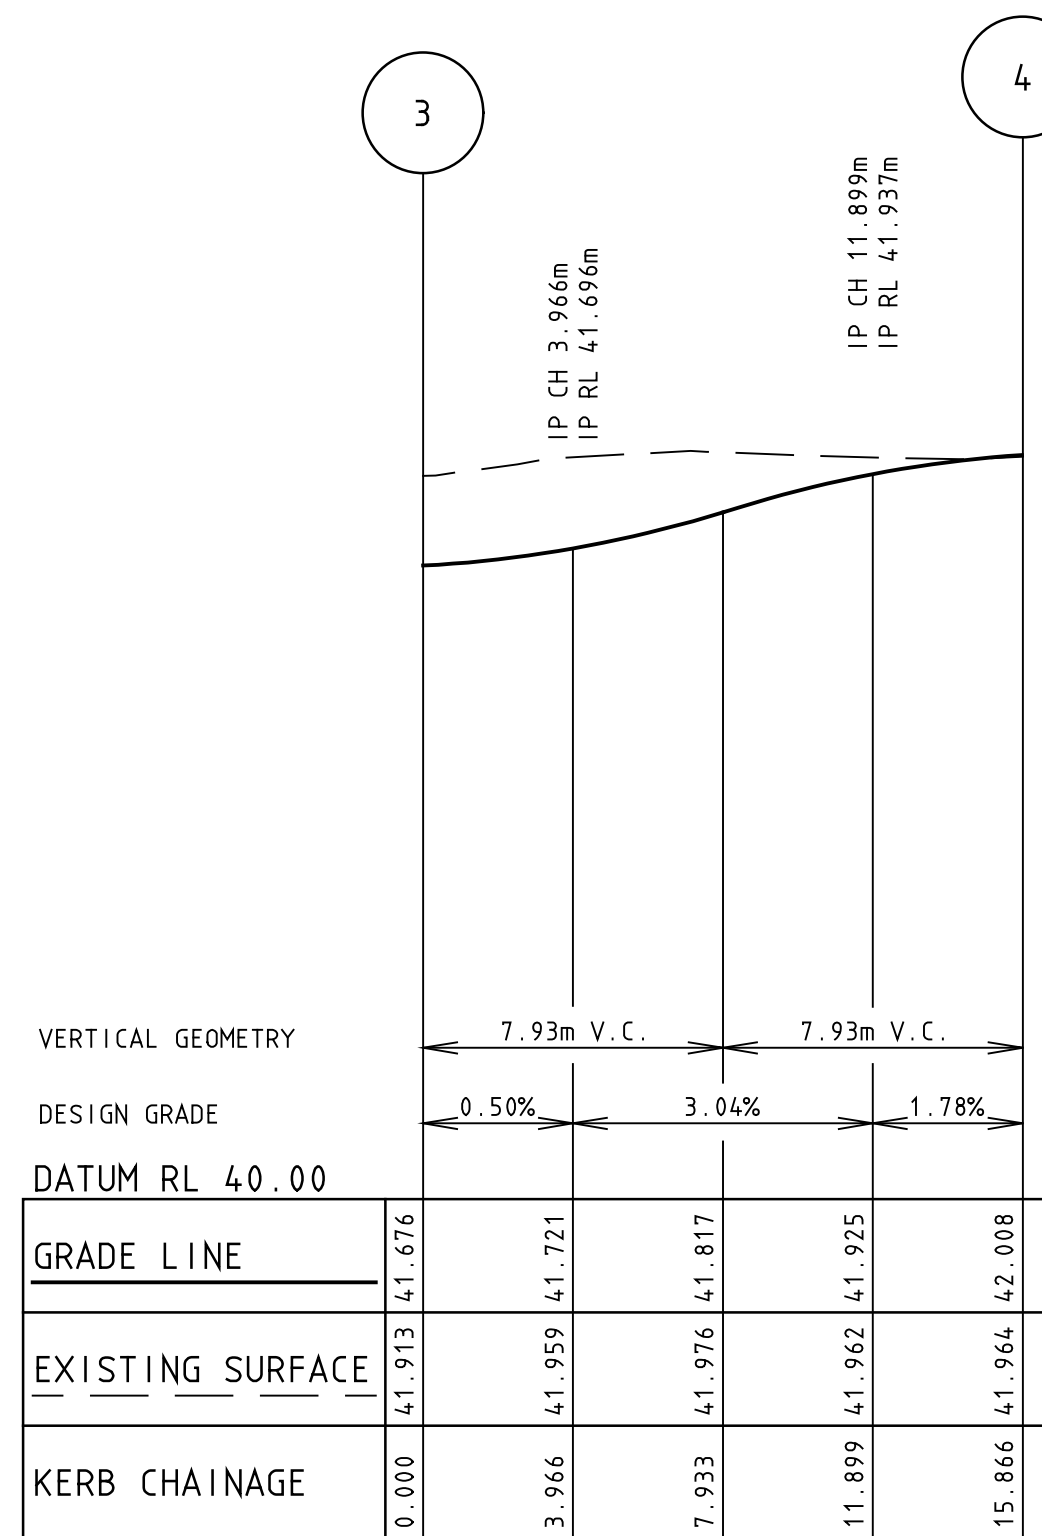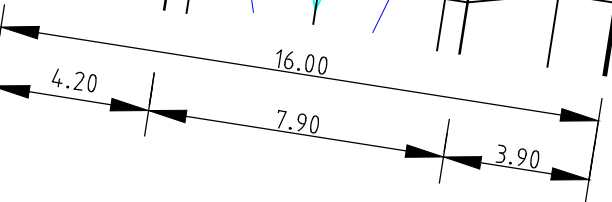


KERB LIP D

Horizontal scale 1:200
Vertical scale 1:20

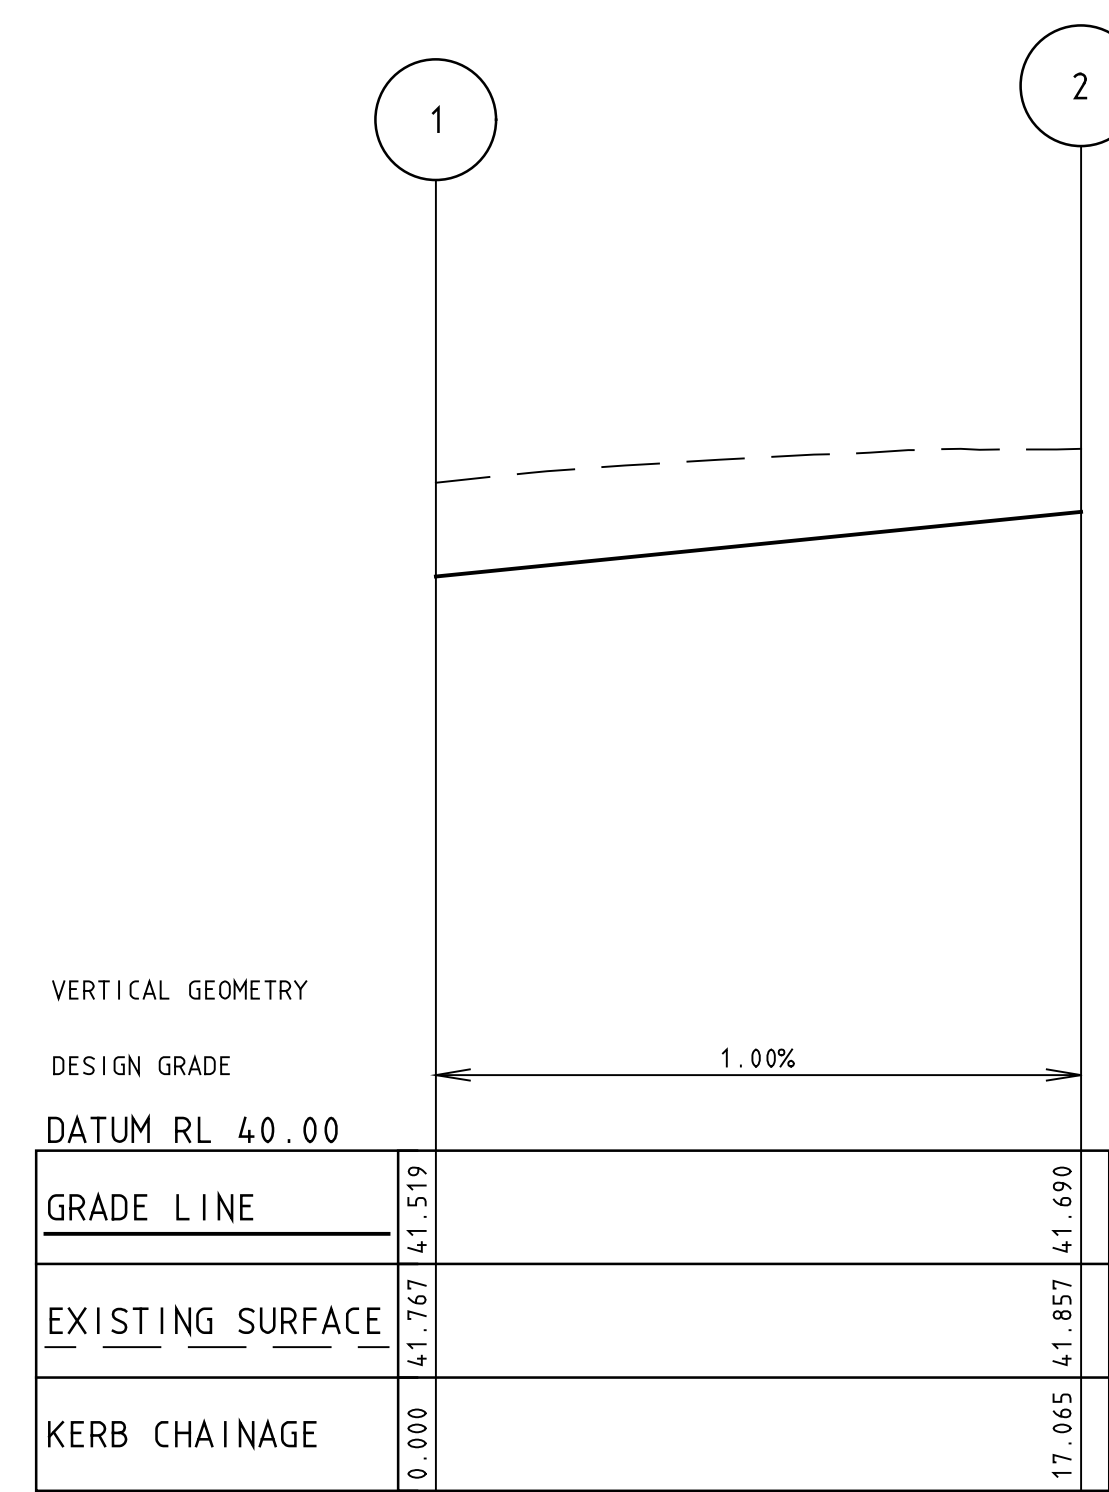

KERB LIP C

Horizontal scale 1:200
Vertical scale 1:20

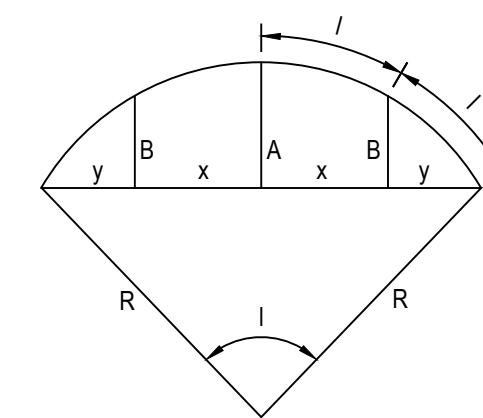


LIP PROFILE SETOUT

SETOUT DETAILS


AS CONSTRUCTED

LEGEND	
GAS MAIN	HOUSE DRAIN PROPOSED/EX.
WATER MAIN	PROPERTY INLET, DRAINAGE PITS
RECYCLED WATER MAIN	EX./FUT. INLET, DRAINAGE PITS
ELECTRICITY CABLE	DRAINAGE PIT STAGE/NUMBER
TELECOMMUNICATIONS CABLE	EX. SEWER LINE AND STRUCTURES
WATER CONDUIT	EX. SEWER LINE AND STRUCTURES
GAS CONDUIT	EX./FUT. KERB AND CHANNEL
RECYCLED WATER CONDUIT	EX./FUT. KERB AND CHANNEL
COMBINED SERVICES CONDUIT	KERB TO BE REMOVED OFFSITE
T.B.M.	STREET SIGN
P.S.M.	CHAINAGES AND TANGENT POINTS
EXISTING SURFACE LEVEL	FINISHED LEVEL (TITLE BOUNDARY)
DESIGN TOP/TOE OF BATTER LEVEL	DESIGN PAVEMENT LEVEL
PROPOSED CONTOUR LINE & LEVEL	EXISTING CONTOUR LINE & LEVEL
FILLING IN EXCESS OF 200mm	CATCH DRAIN AND INVERT LEVEL
EX. BATTER	PROP. BATTER

22 Business Park Drive
Notting Hill VIC 3168
A.C.N. 006 550 803
E: consulting@dpmvic.com.au
W: www.dpmvic.com.au
T: (03) 9538 5000

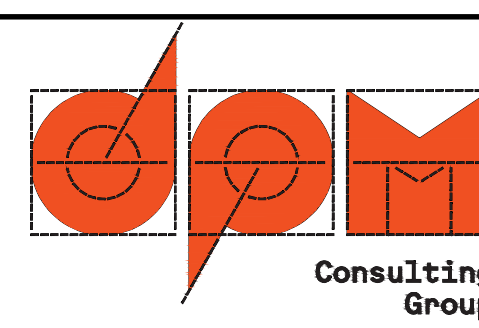

DRAWN: J.DEMERTZIDIS	AUTHORITY: CARDINIA SHIRE COUNCIL	SCALE 1:200
DESIGNED: J.DEMERTZIDIS	PROJECT: GERANIUM ESTATE - STAGE 1	LEVEL DATUM AHD
CHECKED: S.MAKARAS	ROAD & DRAINAGE	SHEET 04 OF 14
AUTHORISED: M.COLE	DETAILS: INTERSECTION DETAILS - SHEET 2 OF 2	DRAWING No. 3257/01/R04
PE REG NO: PE1124072		REV. AC1
DATE: 06/02/2025		

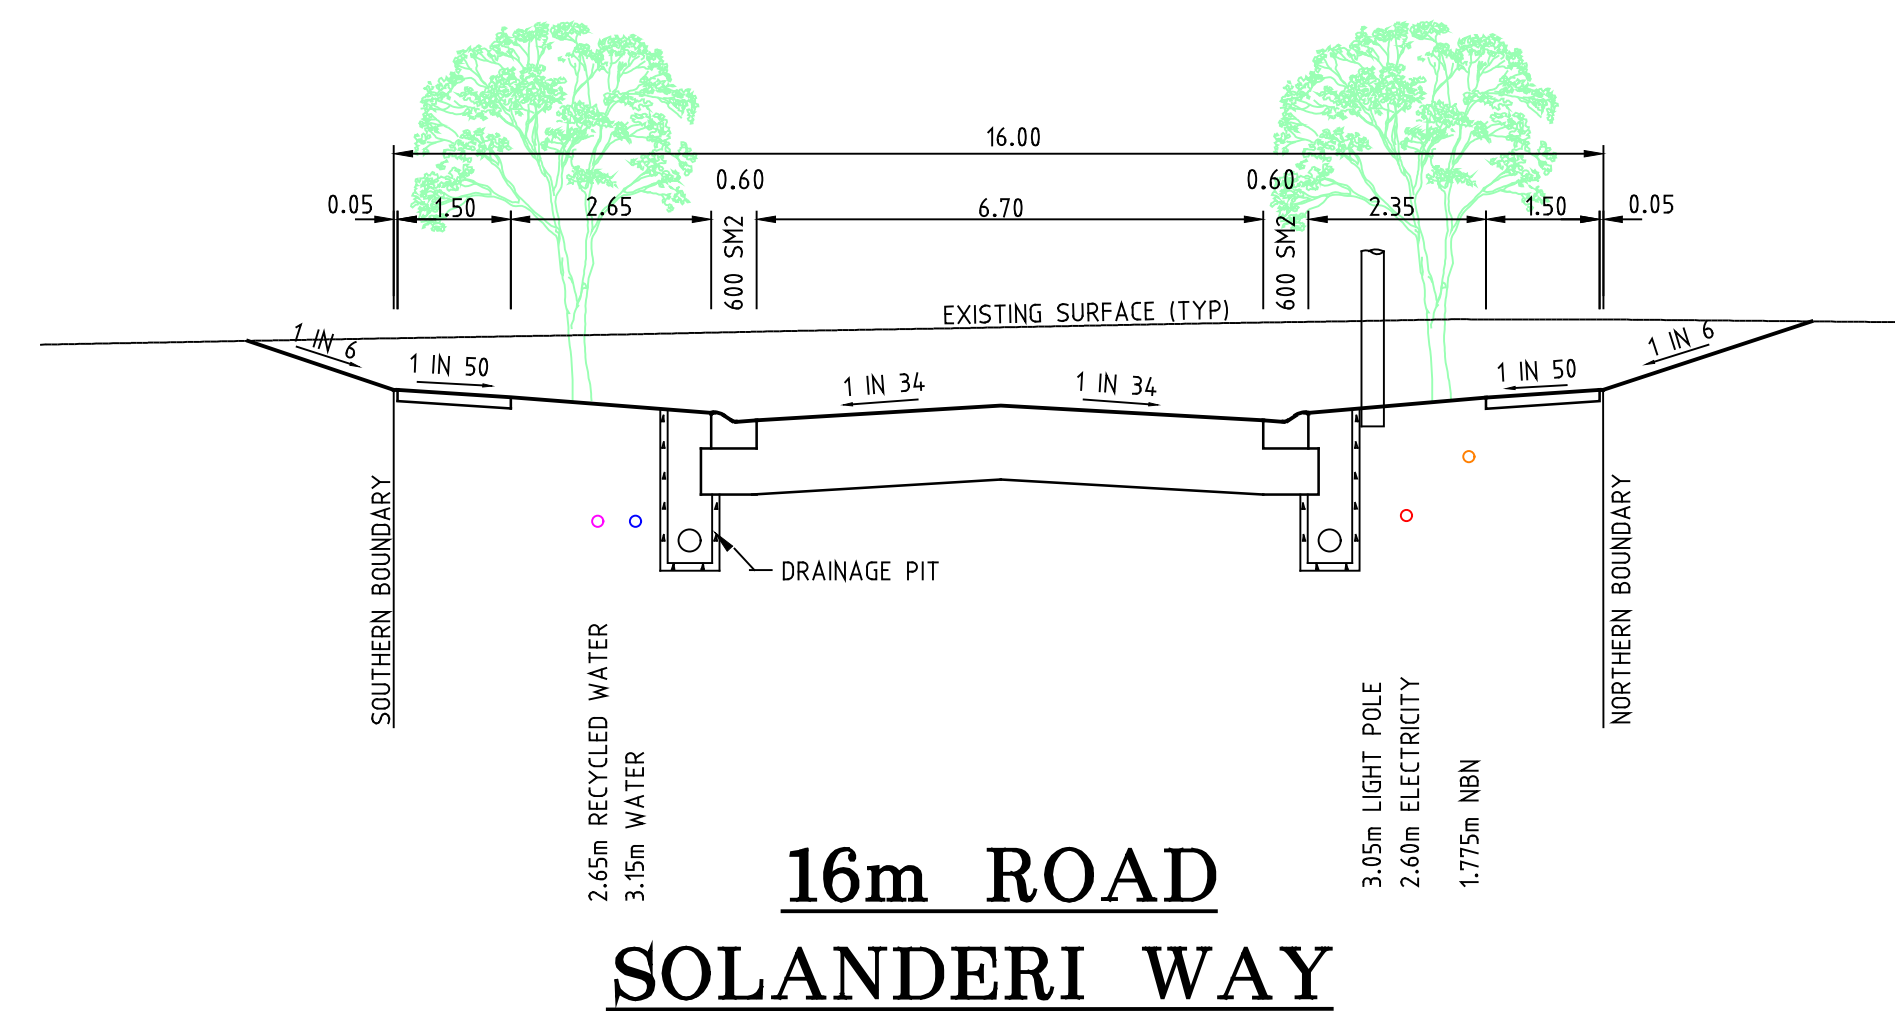[illegible]



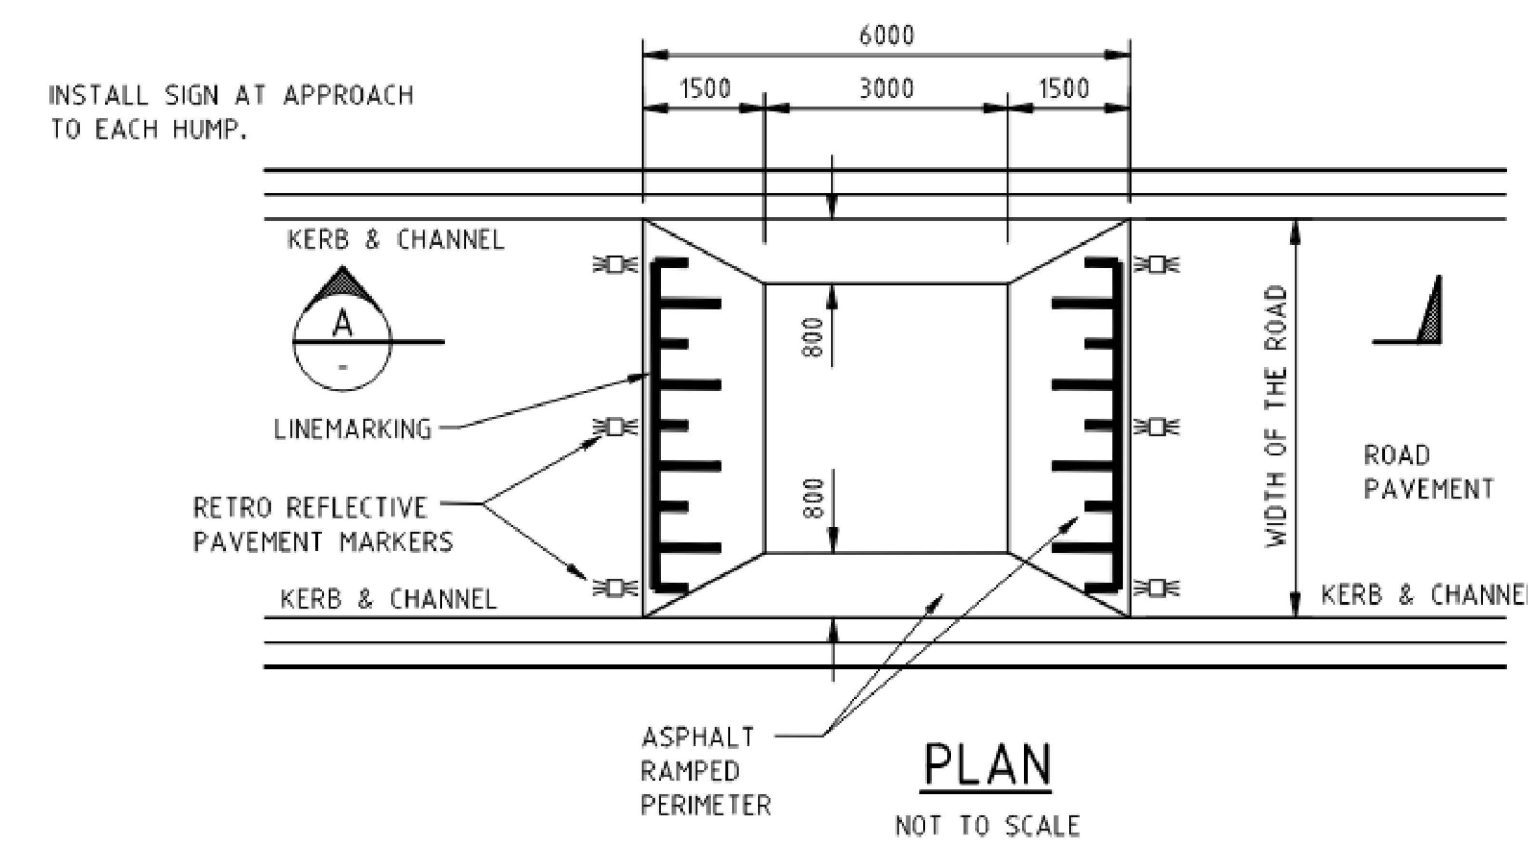





Diagram illustrating the relationship between the existing surface, the batter level, and the lot fall. The diagram shows a cross-section of a property boundary. The existing surface is labeled "EXISTING SURFACE (TYP)". The batter level is labeled "T LEVEL (TOP OF BATTER)". The lot fall is indicated by a dashed line labeled "LOT FALL". The distance between the existing surface and the batter level is labeled "VARIES". A "100mm AG DRAIN" is shown at the base of the batter level.

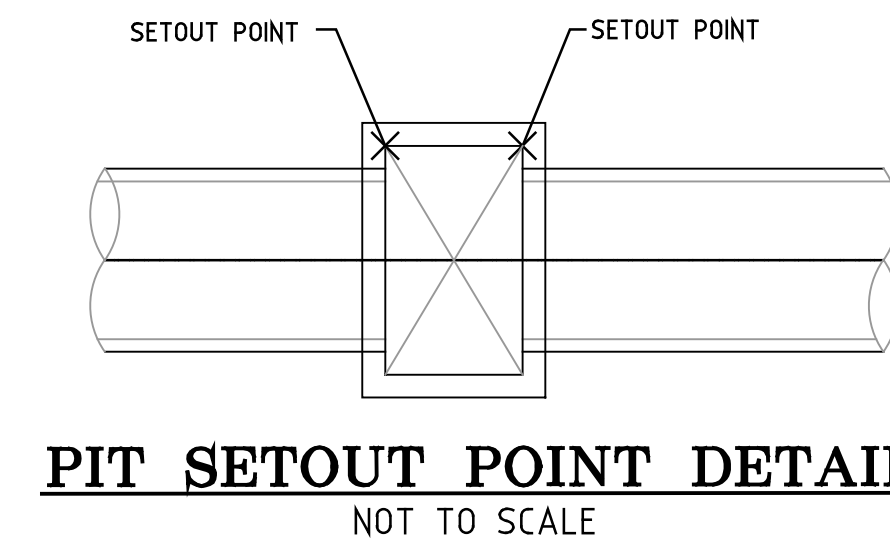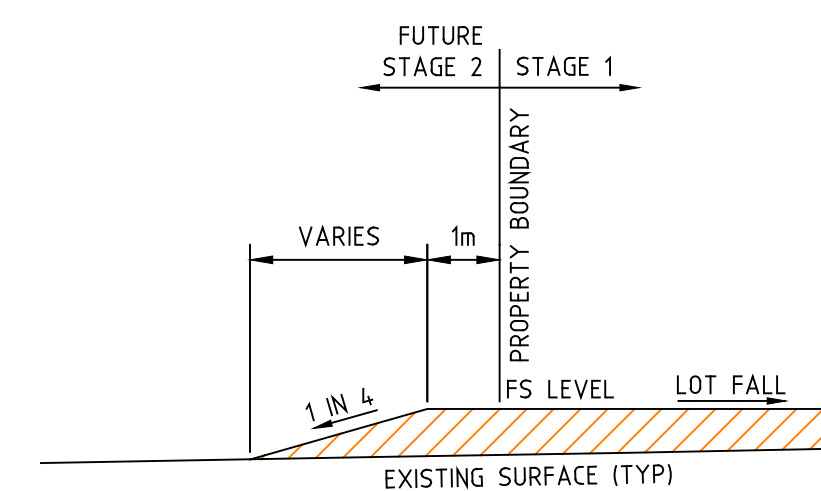

TEMP. BATTER TREATMENT - REAR/SIDE LOTS 19-30
BATTER DETAIL B
 NOT TO SCALE

AS CONSTRUCTED










[illegible]

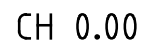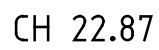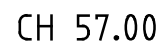

22 Business Park Drive
Notting Hill VIC 3168
A.C.N. 006 550 803
E: consulting@dpmvic.com.au
W: www.dpmvic.com.au
T: (03) 9538 5000



DRAWN: J.DEMERTZIDIS	AUTHORITY: CARDINIA SHIRE COUNCIL	SCALE H: 1:500 V: 1:50	
DESIGNED: J.DEMERTZIDIS	PROJECT: GERANIUM ESTATE - STAGE 1	LEVEL DATUM AHD	
CHECKED: S.MAKARAS	ROAD & DRAINAGE	SHEET 08 OF 14	
AUTHORISED: M.COLE	DETAILS: RIX ROAD LONGITUDINAL & CROSS SECTIONS	DRAWING No. 3257/01/R08	REV. AC1
PE REG NO: PE1124072			
DATE: 06/02/2025			

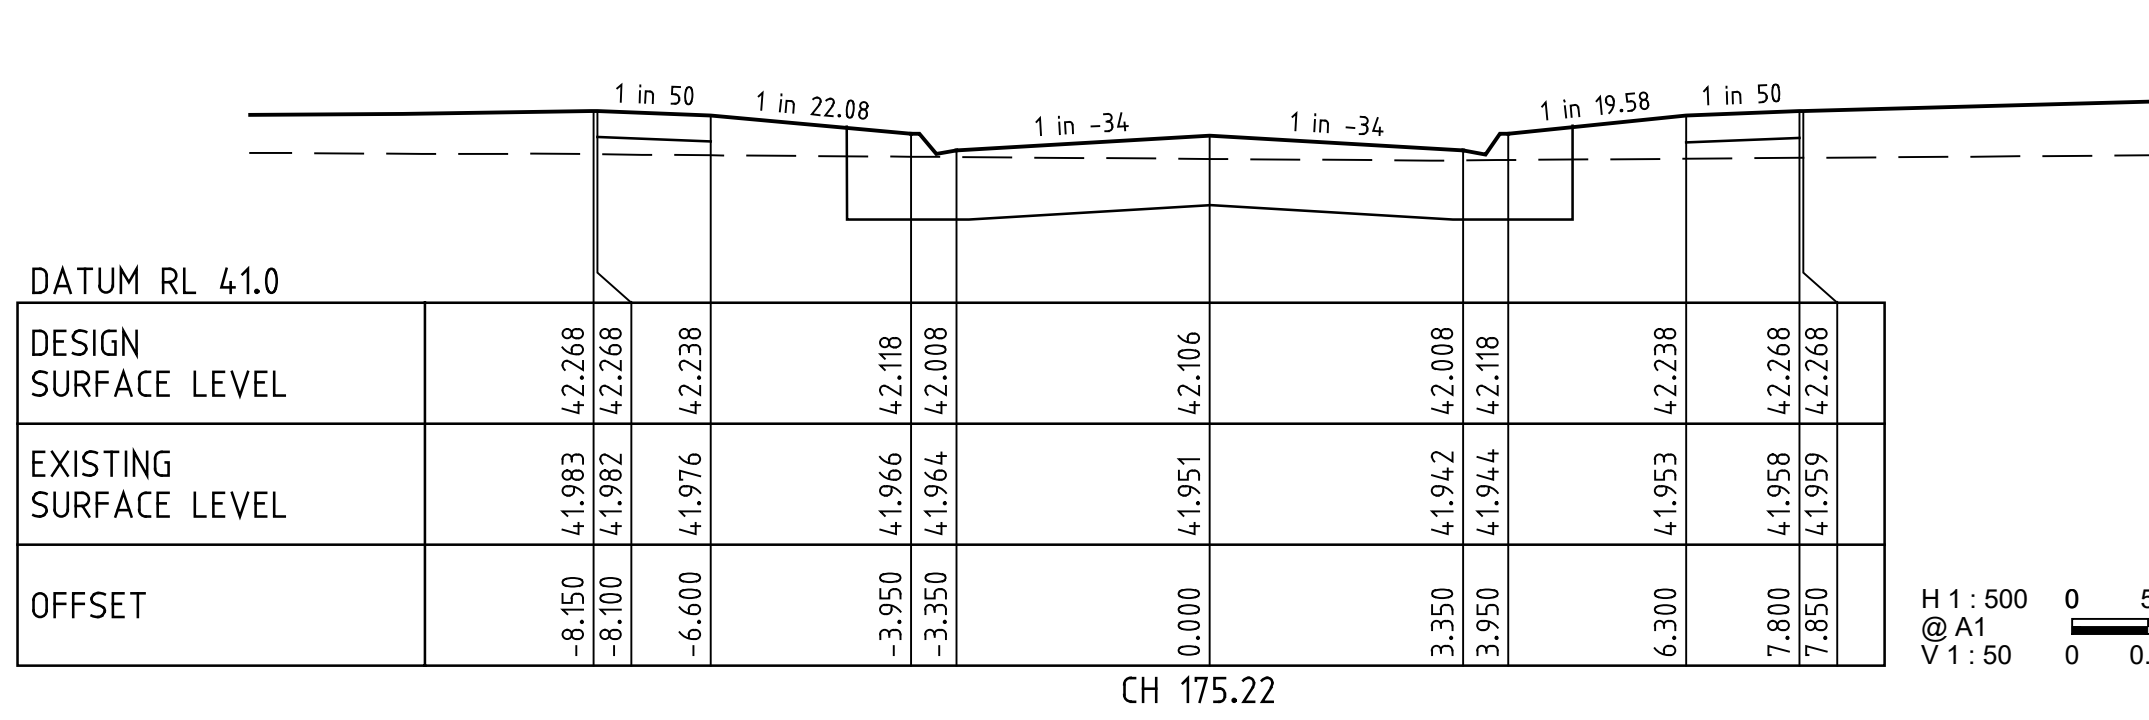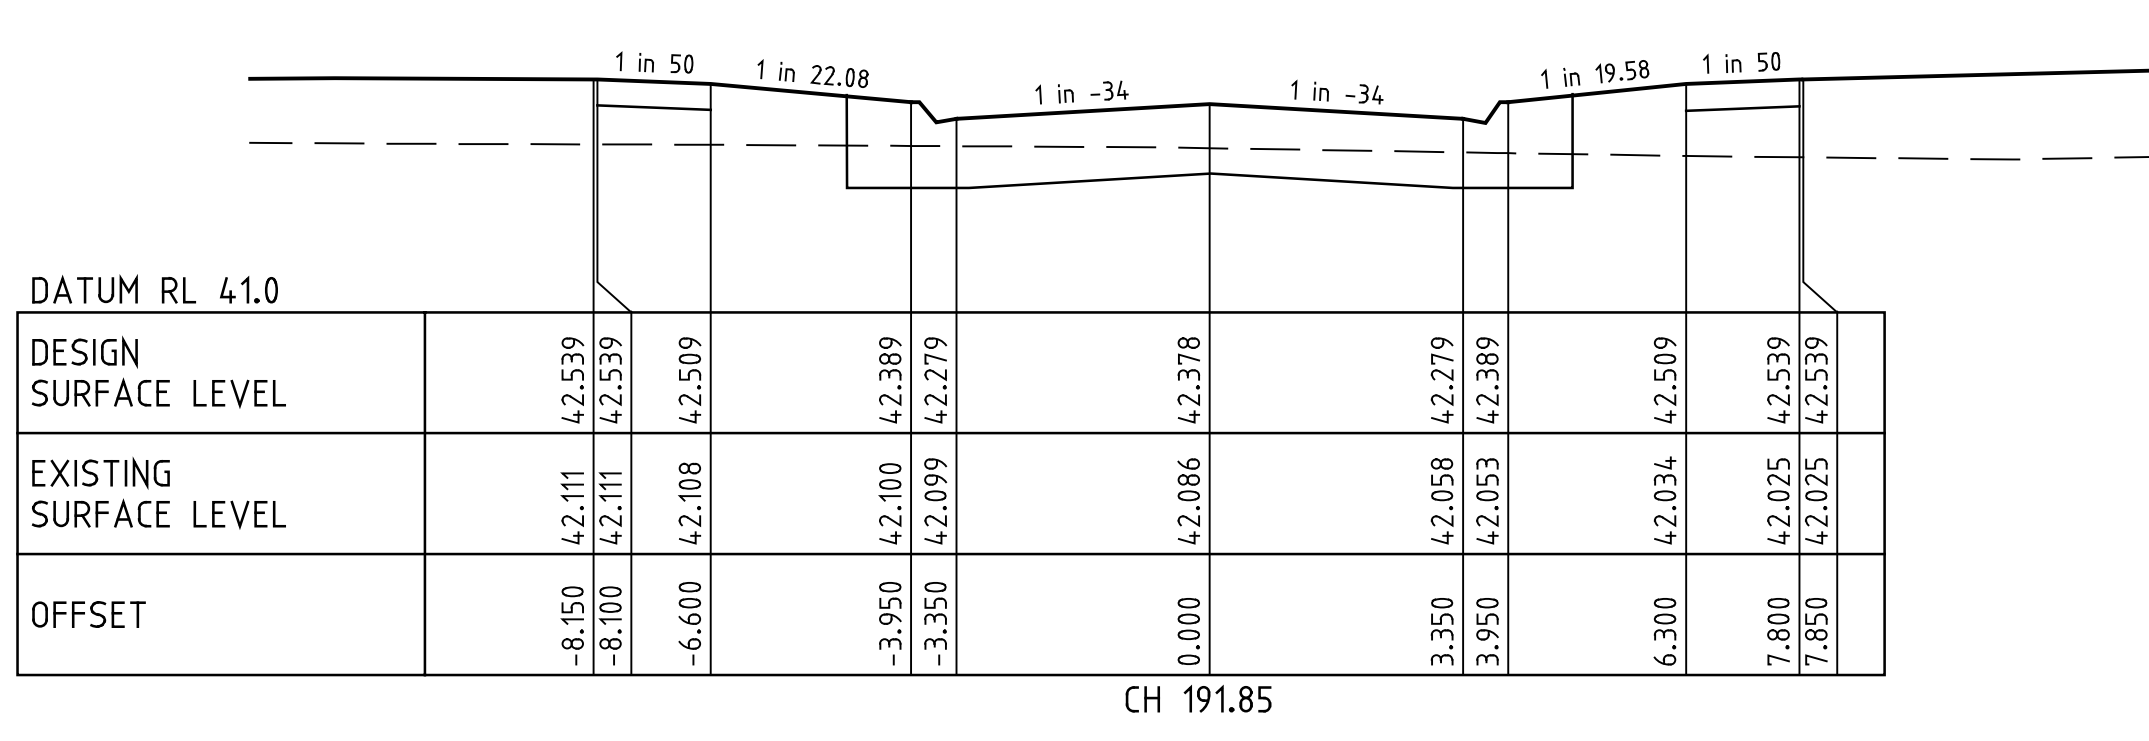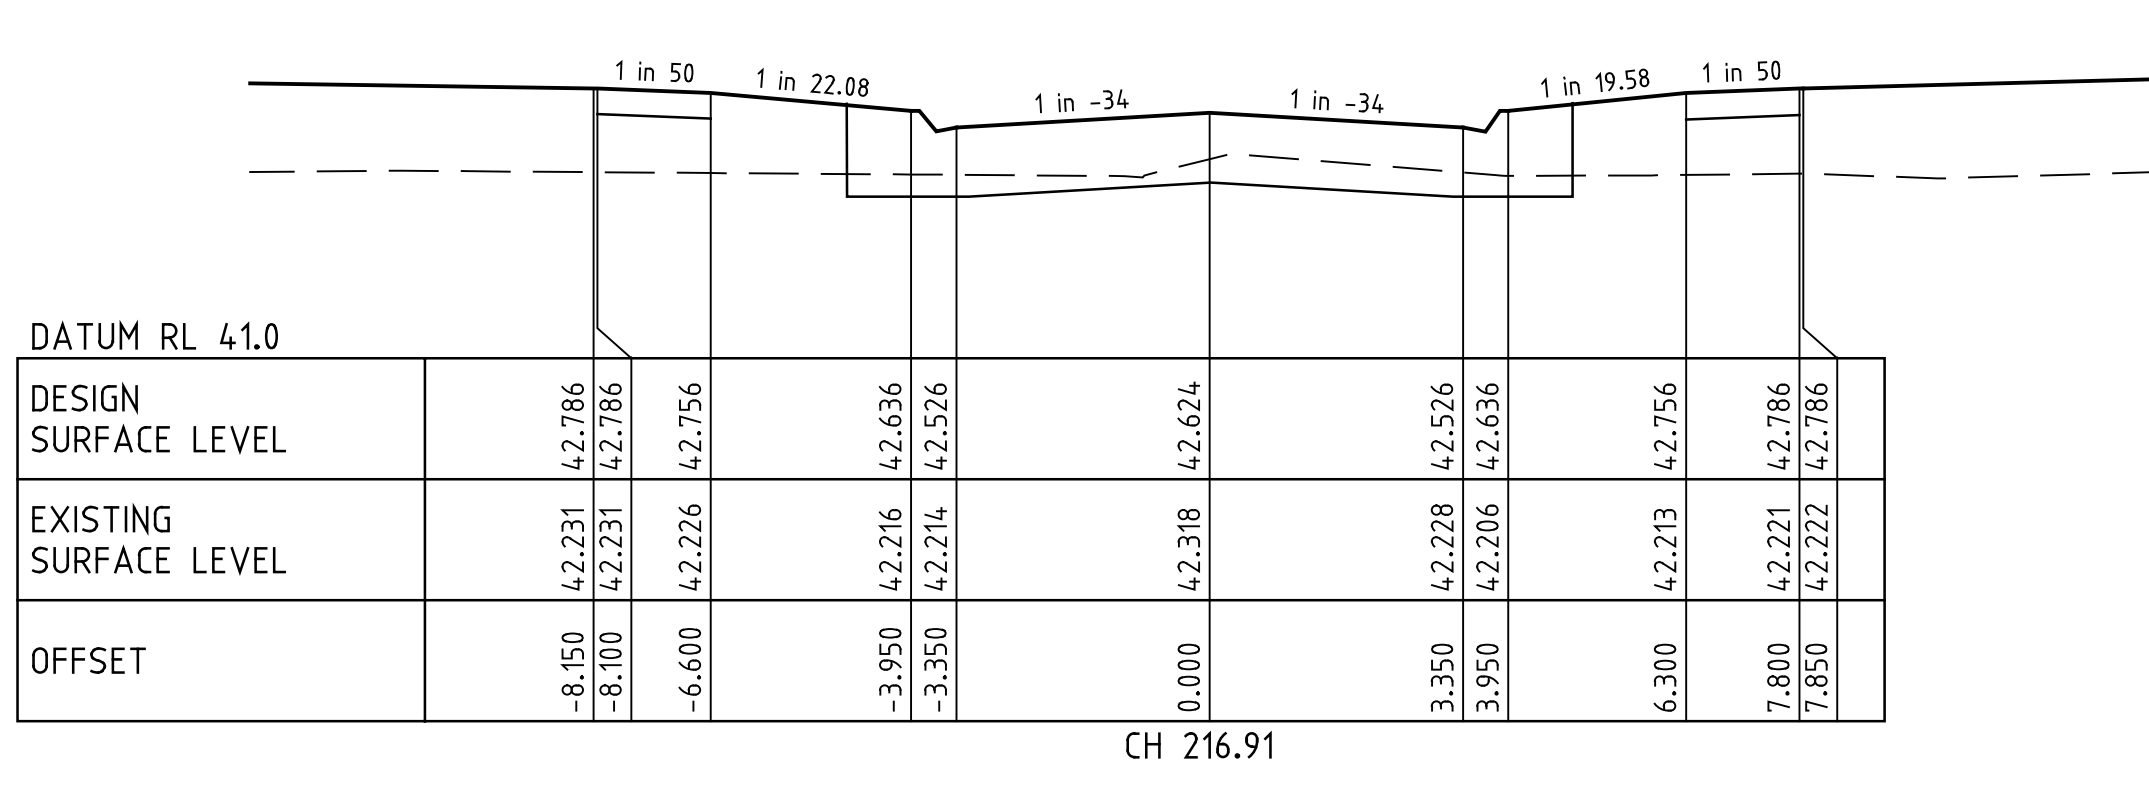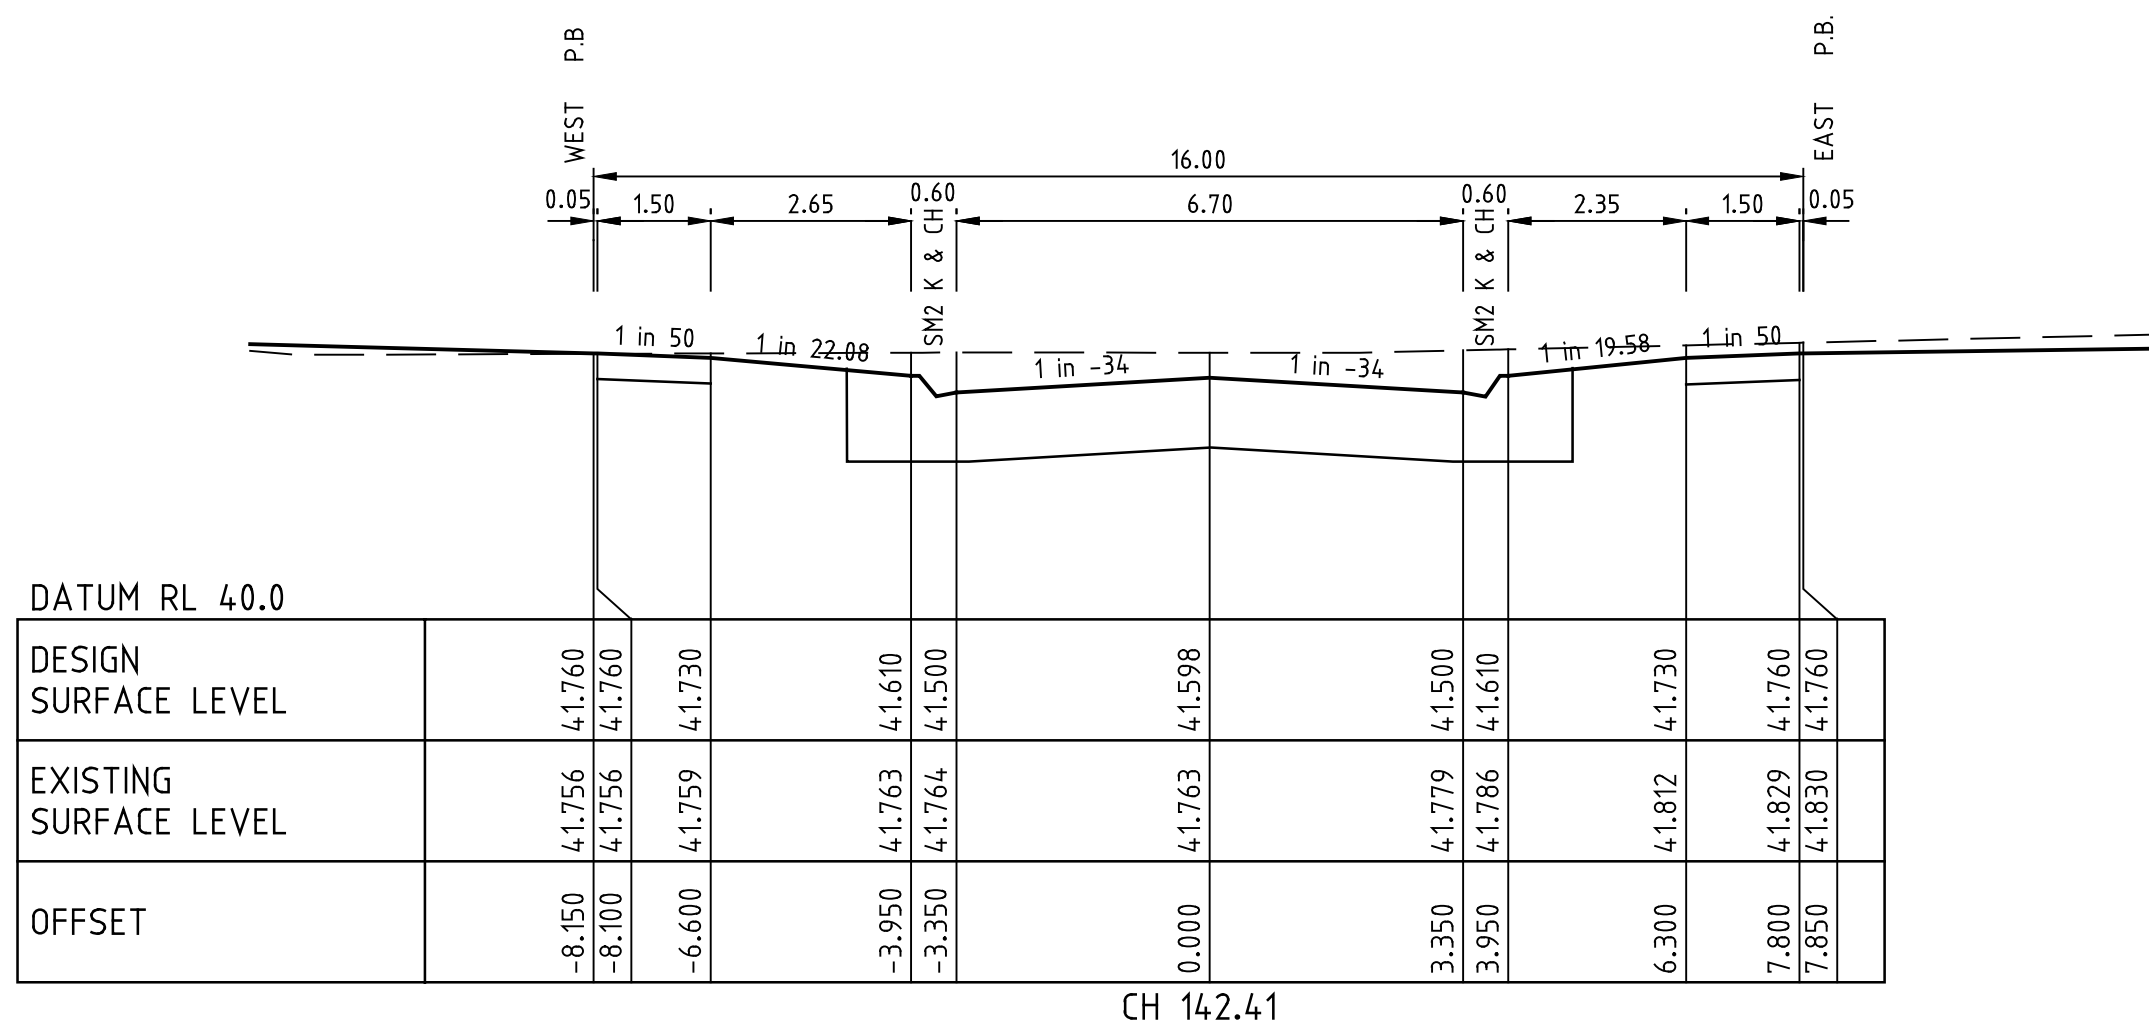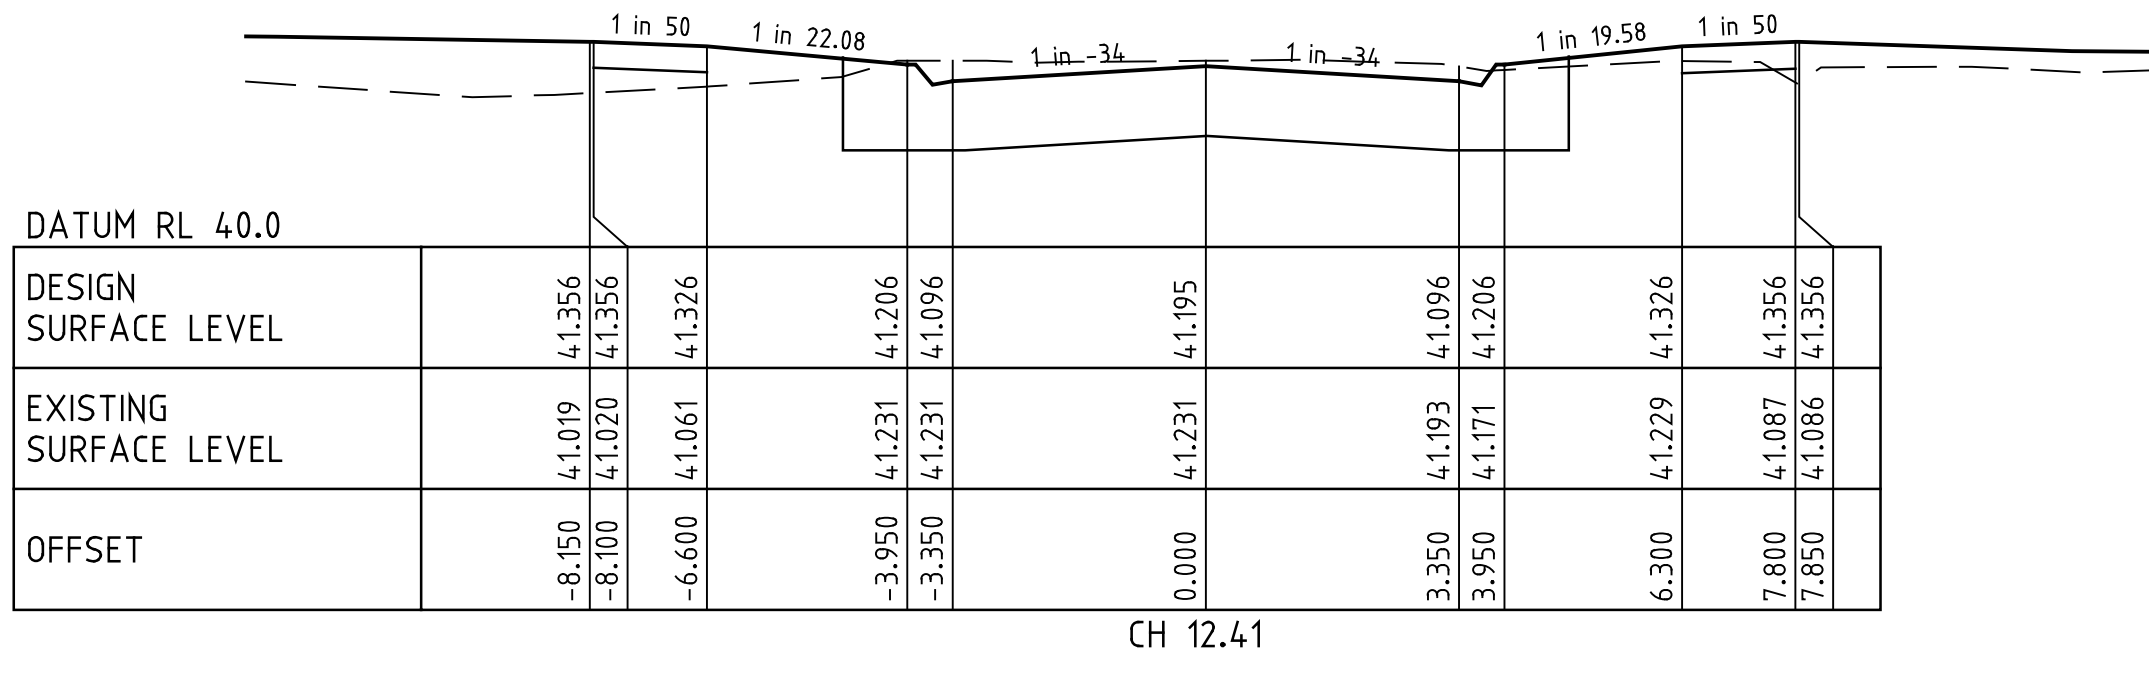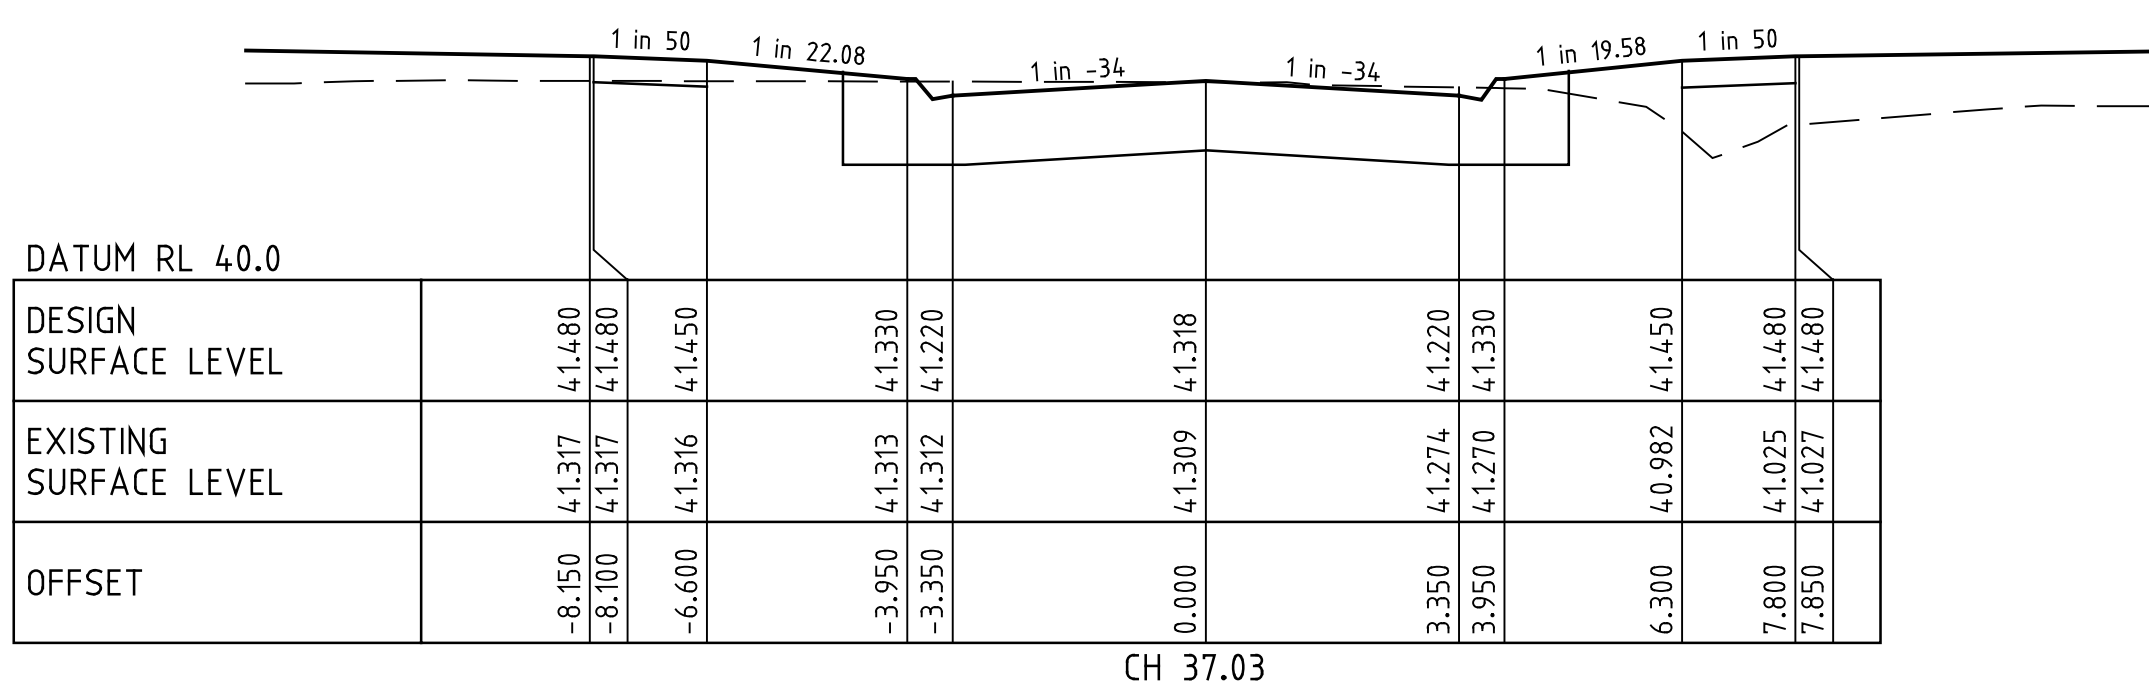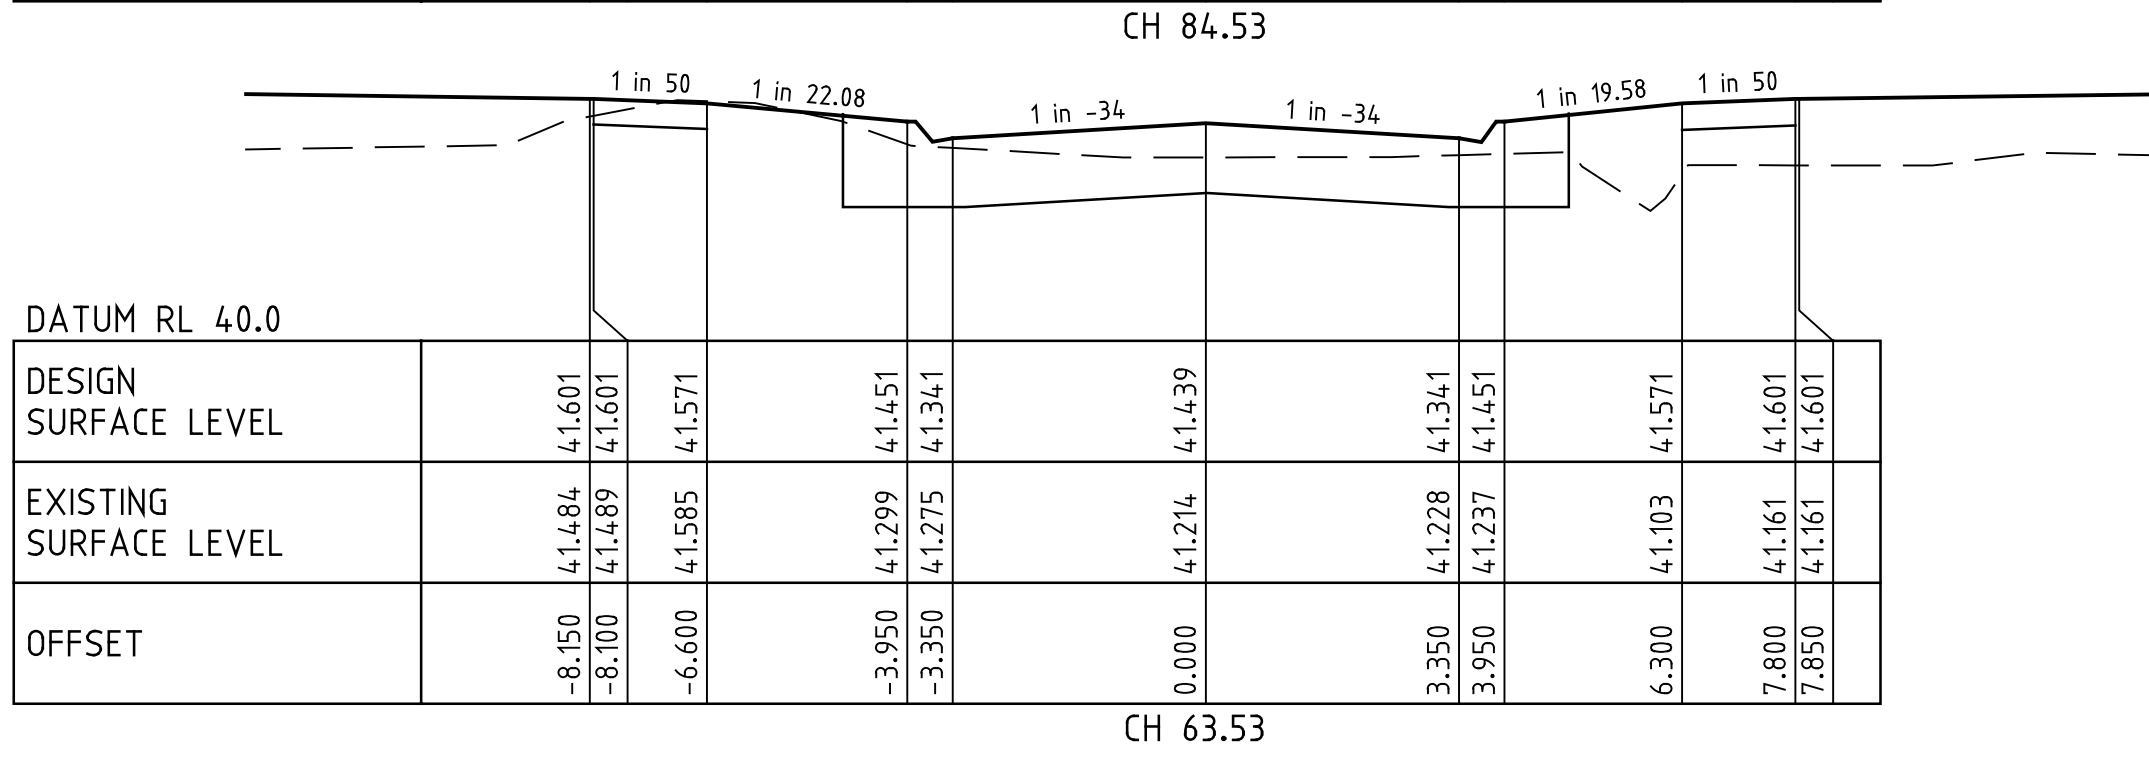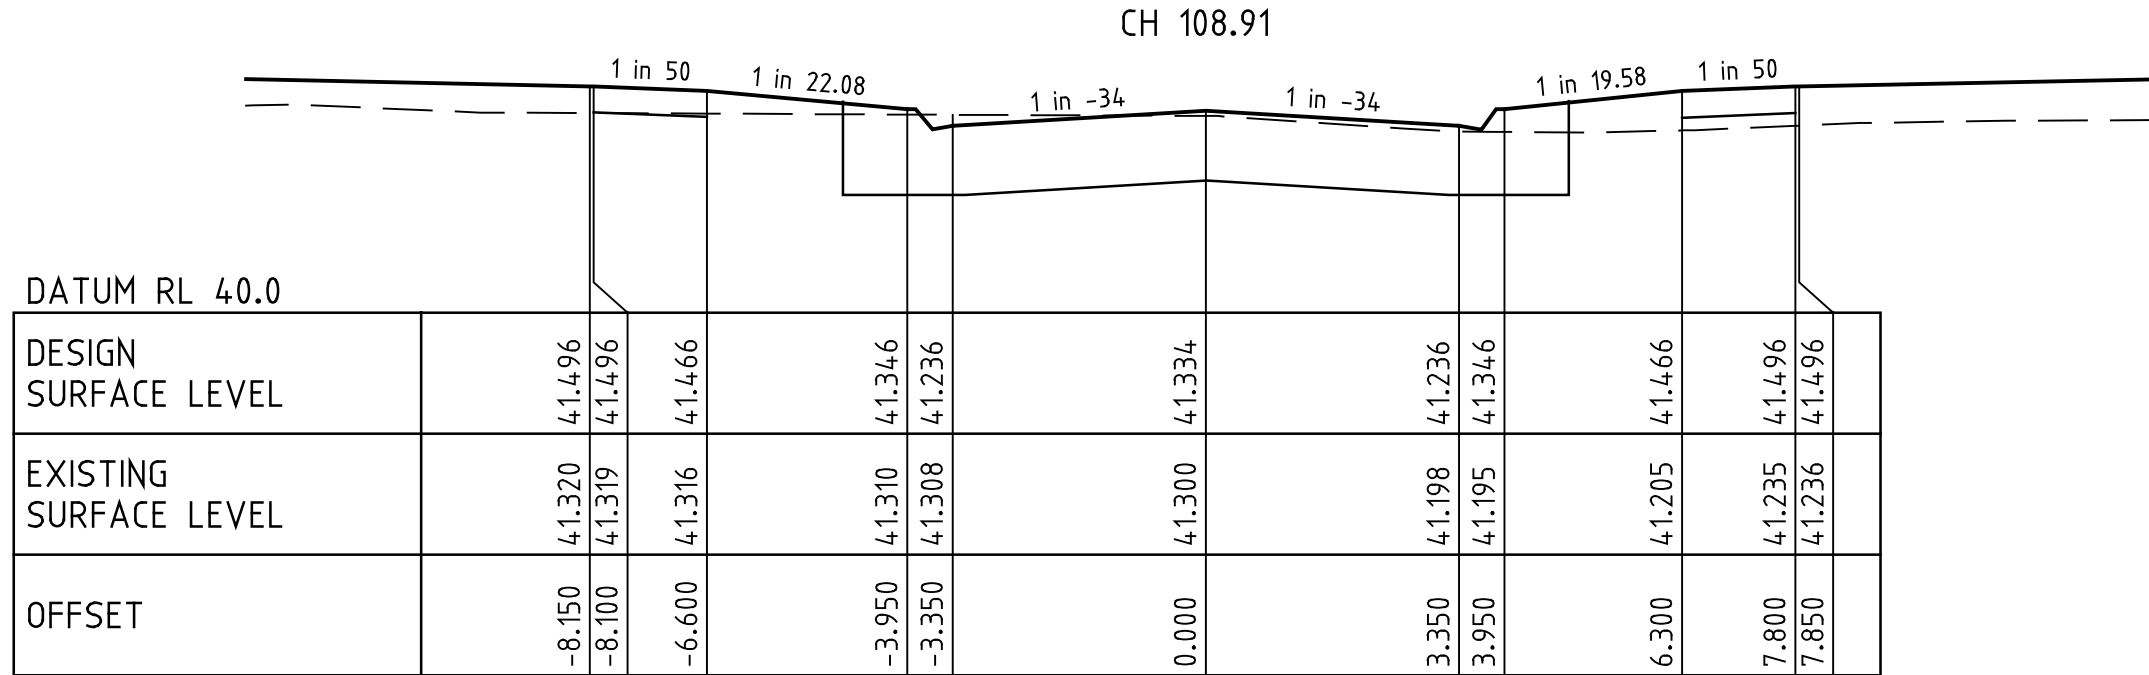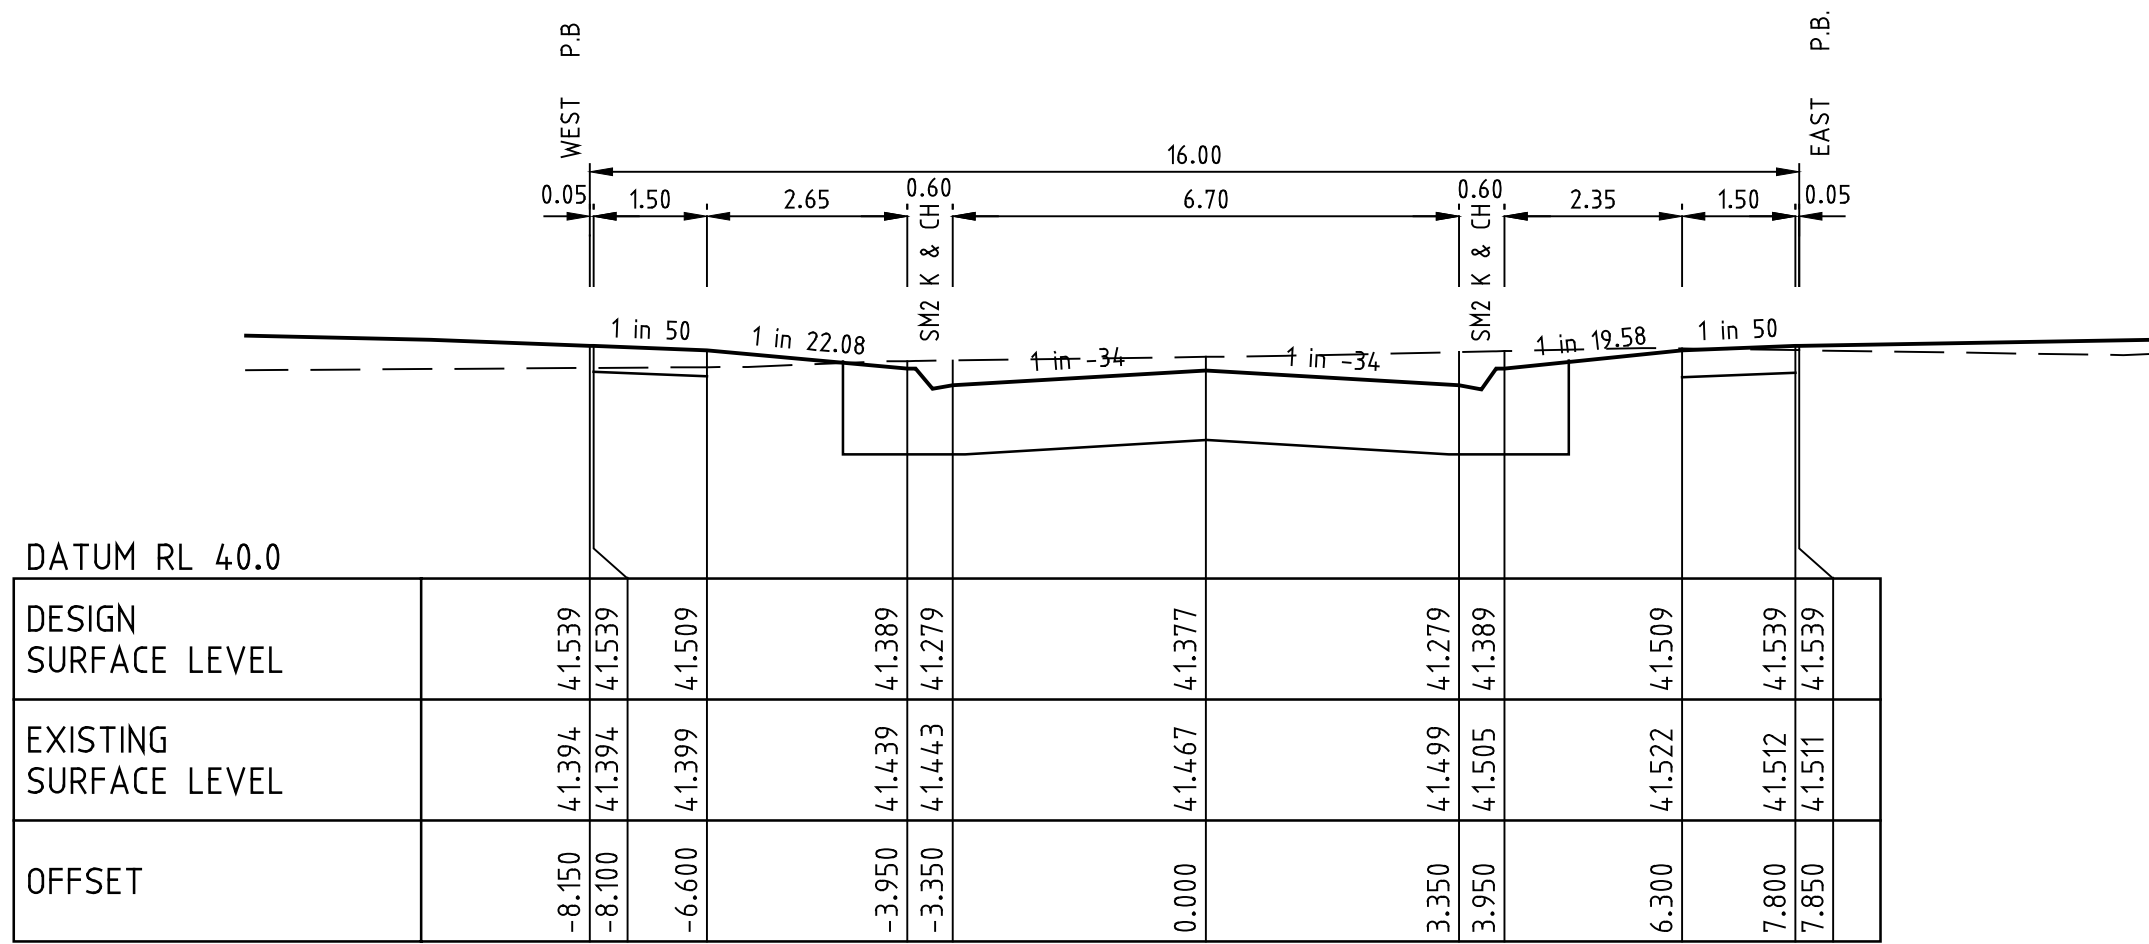

AS CONSTRUCTED

AC1	AS CONSTRUCTED	07/04/2026	M.C.	REG ENG
REV.	REVISION	DATE	REG ENG	

LEGEND	
GAS MAIN	HOUSE DRAIN PROPOSED/EX.
WATER MAIN	PROPERTY INLET, DRAINAGE PITS
RECYCLED WATER MAIN	EX. FUT. INLET, DRAINAGE PITS
ELECTRICITY CABLE	DRAINAGE PIT STAGE/NUMBER
TELECOMMUNICATIONS CABLE	SEWER LINE AND STRUCTURES
WATER CONDUIT	EX. SEWER LINE AND STRUCTURES
GAS CONDUIT	KERB AND CHANNEL
RECYCLED WATER CONDUIT	EX. FUT. KERB AND CHANNEL
COMBINED SERVICES CONDUIT	KERB TO BE REMOVED OFFSITE
T.B.M.	STREET SIGN





CHAINAGES AND TANGENT POINTS	20.06
EXISTING SURFACE LEVEL	721.35
FINISHED LEVEL (TITLE BOUNDARY)	721.35
DESIGN TOP/TOP OF BATTER LEVEL	721.35
DESIGN PAVEMENT LEVEL	721.35
PROPOSED CONTOUR LINE & LEVEL	721.35
EXISTING CONTOUR LINE & LEVEL	721.35
FILLING IN EXCESS OF 200mm	721.35
CATCH DRAIN AND INVERT LEVEL	721.35
EX. BATTER	721.35
PROP. BATTER	721.35

22 Business Park Drive
Notting Hill VIC 3168
A.C.N. 006 550 803
E: consulting@dpmvic.com.au
W: www.dpmvic.com.au
T: (03) 9538 5000

Consulting Group


DRAWN: J.DEMERTZIDIS	AUTHORITY: CARDINIA SHIRE COUNCIL
DESIGNED: J.DEMERTZIDIS	PROJECT: GERANIUM ESTATE - STAGE 1
CHECKED: S.MAKARAS	DETAILS: TATJANA WAY CROSS SECTIONS
AUTHORISED: M.COLE	
PE REG NO: PE1124072	
DATE: 06/02/2025	

SCALE	H: 1:500 V: 1:50
LEVEL DATUM	AHD
SHEET	10 OF 14
DRAWING No.	3257/01/R10
REV.	AC1

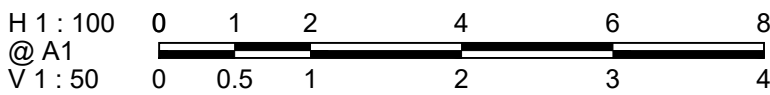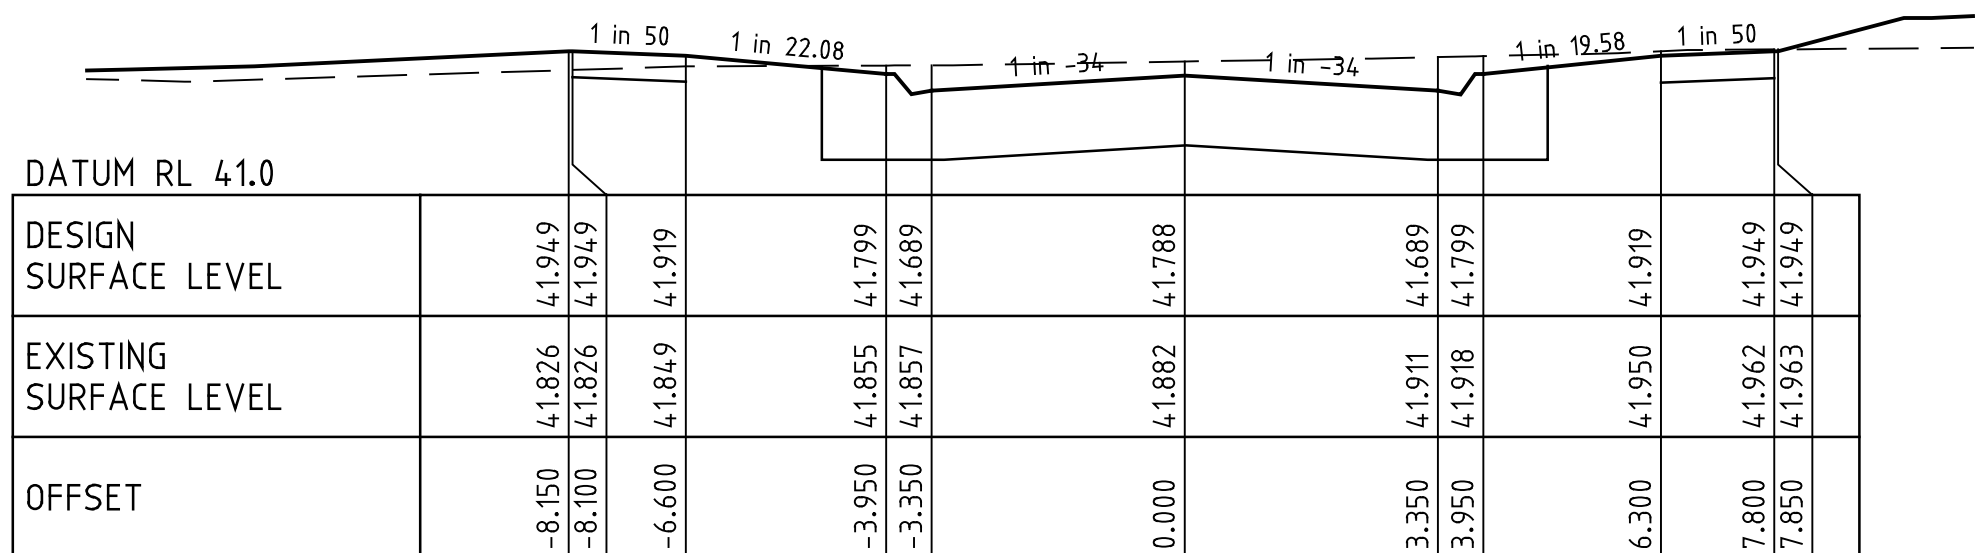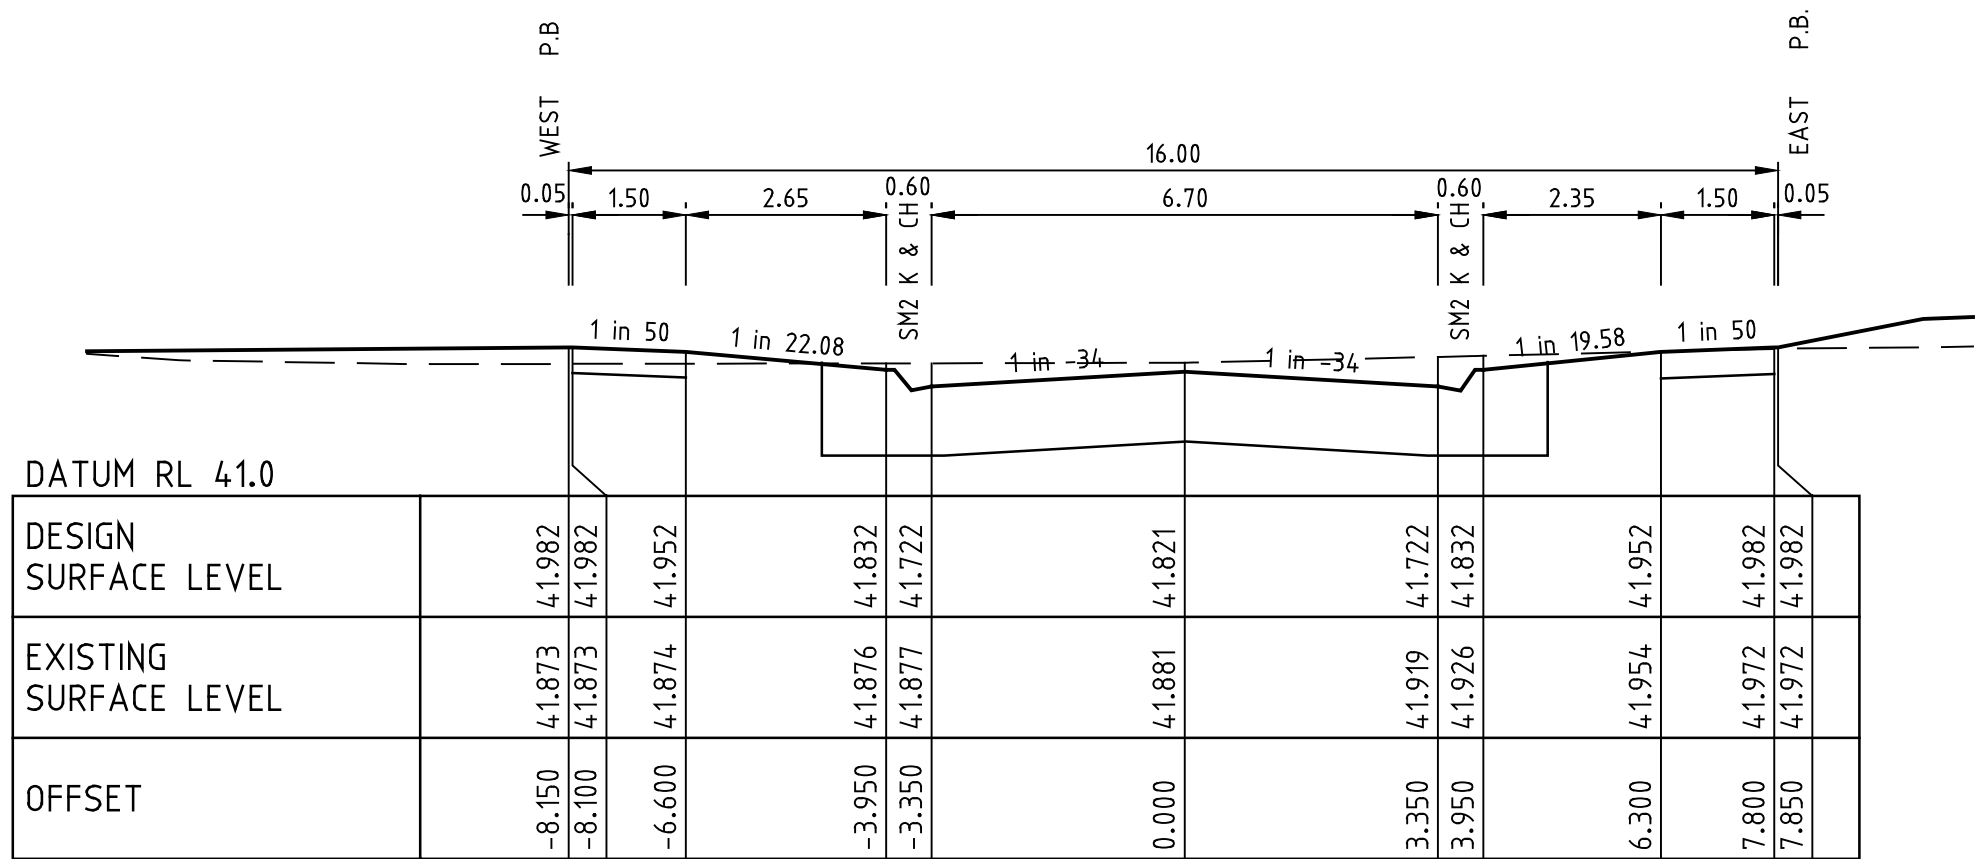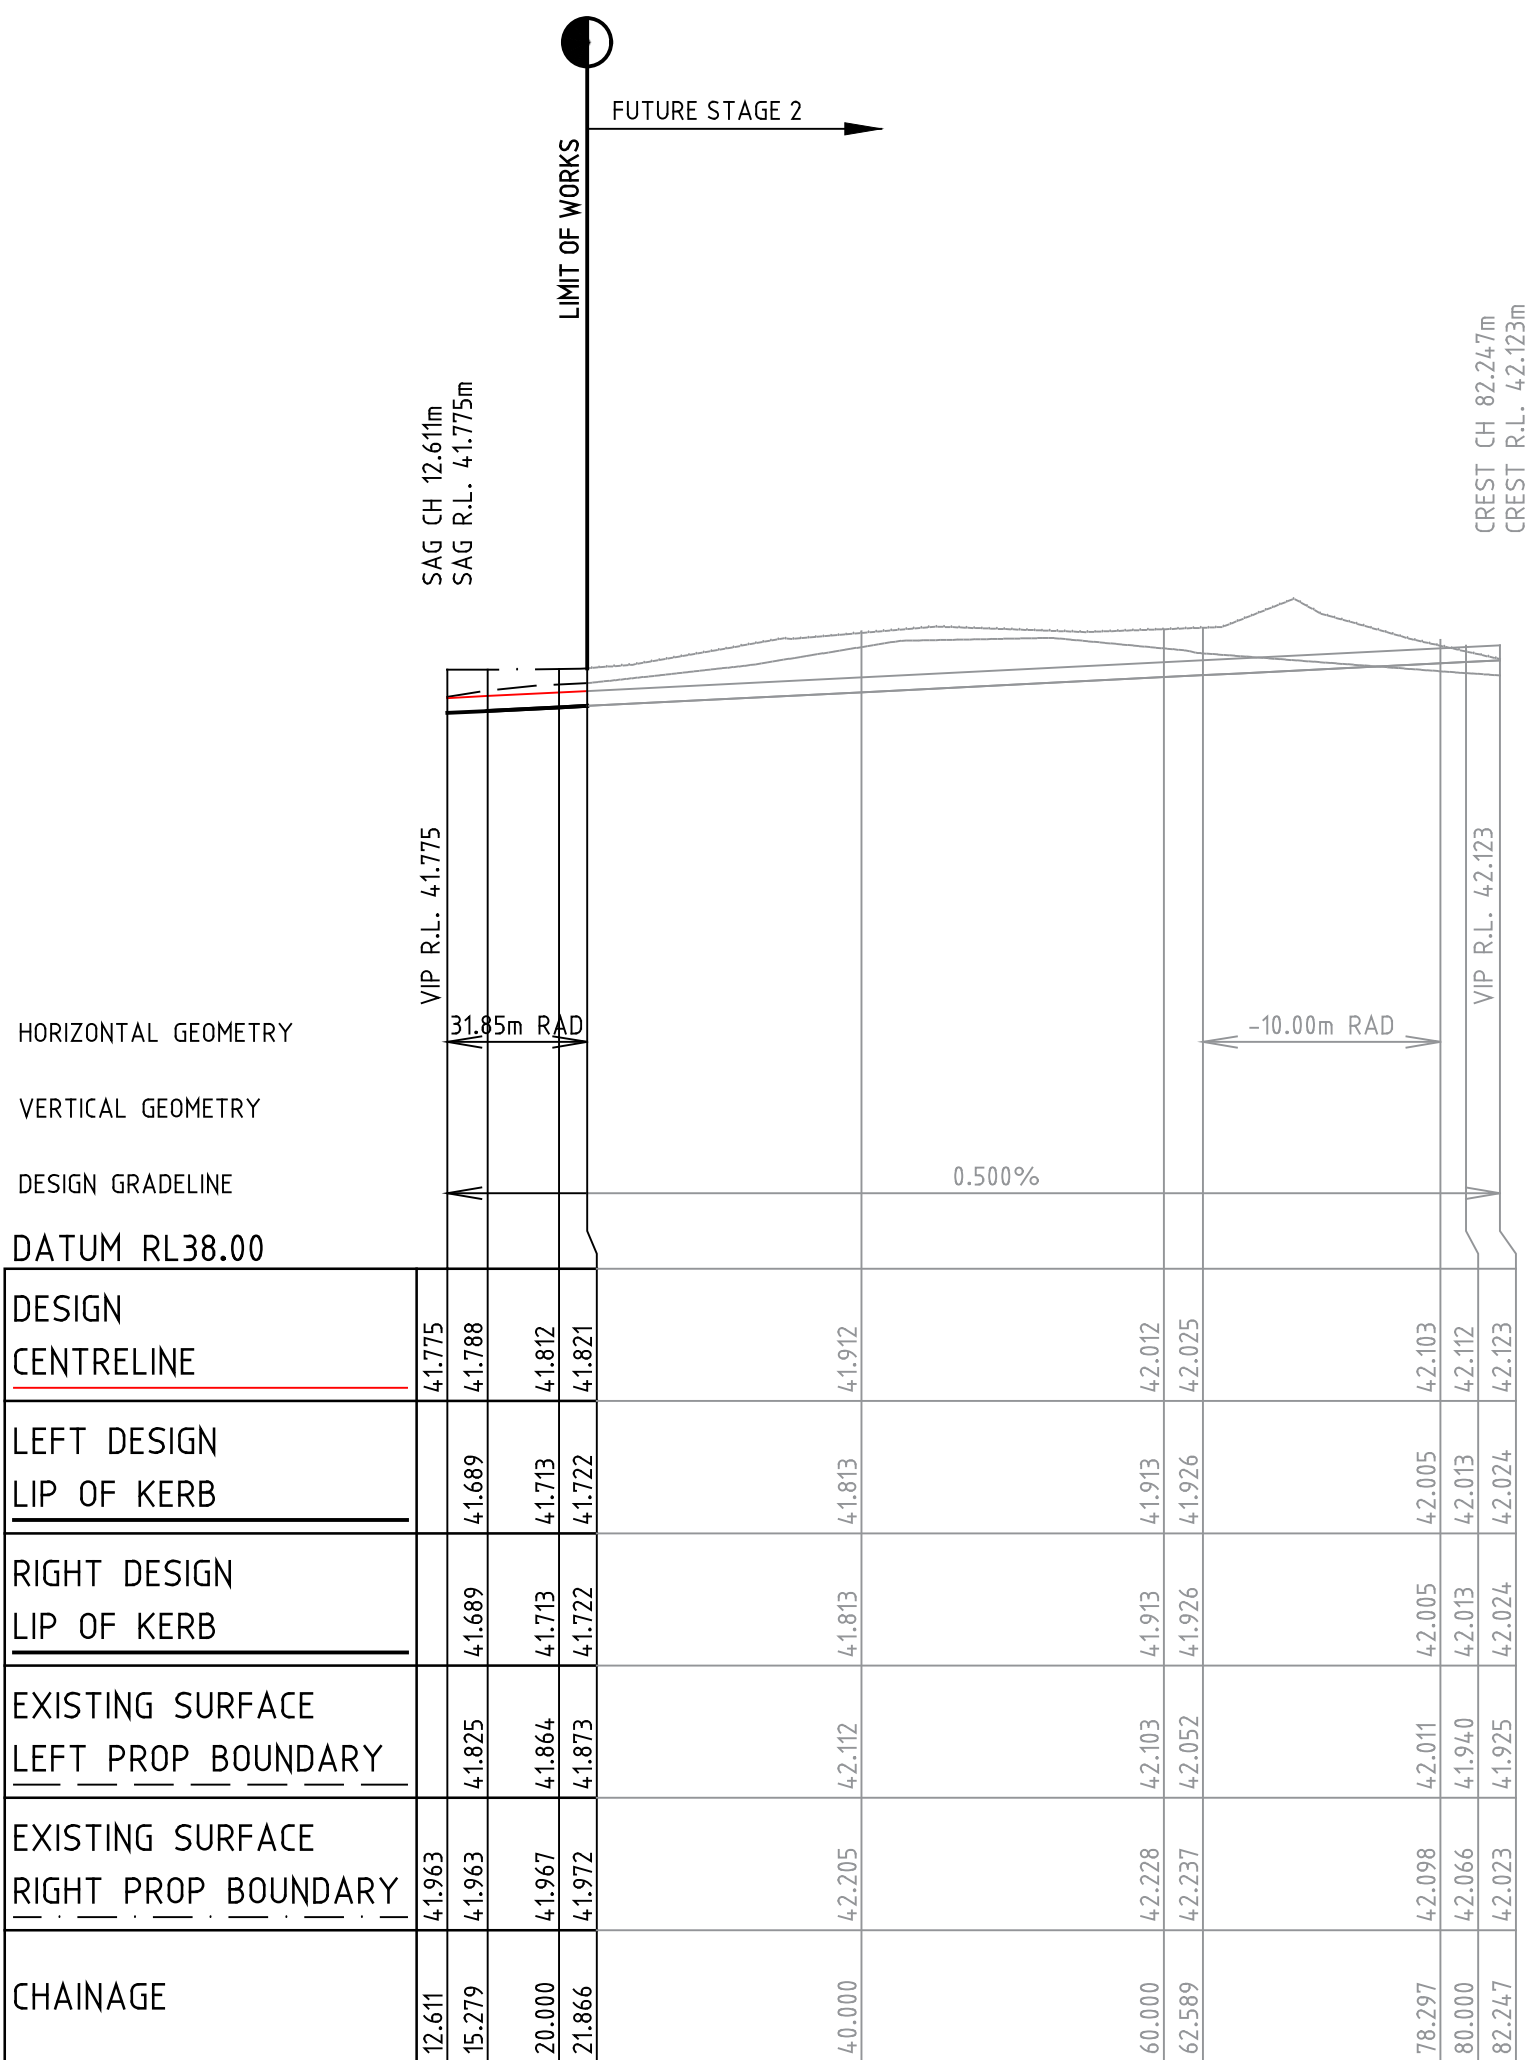

AS CONSTRUCTED

AC1	AS CONSTRUCTED	07/04/2026	M.C.	REG ENG	LEGEND	22 Business Park Drive Notting Hill VIC 3168 A.C.N. 006 550 803 E: consulting@dpmvic.com.au W: www.dpmvic.com.au T: (03) 9538 5000		DRAWN: J.DEMERTZIDIS DESIGNED: J.DEMERTZIDIS CHECKED: S.MAKARAS AUTHORISED: M.COLE PE REG NO: PE1124072 DATE: 06/02/2025	AUTHORITY: CARDINIA SHIRE COUNCIL PROJECT: GERANIUM ESTATE - STAGE 1 ROAD & DRAINAGE DETAILS: SOLANDERI WAY LONGITUDINAL & CROSS SECTIONS	SCALE H: 1:100 V: 1:50 LEVEL DATUM AHD SHEET 11 OF 14 DRAWING No. 3257/01/R11 REV. AC1
-----	----------------	------------	------	---------	--------	---	---	---	--	--

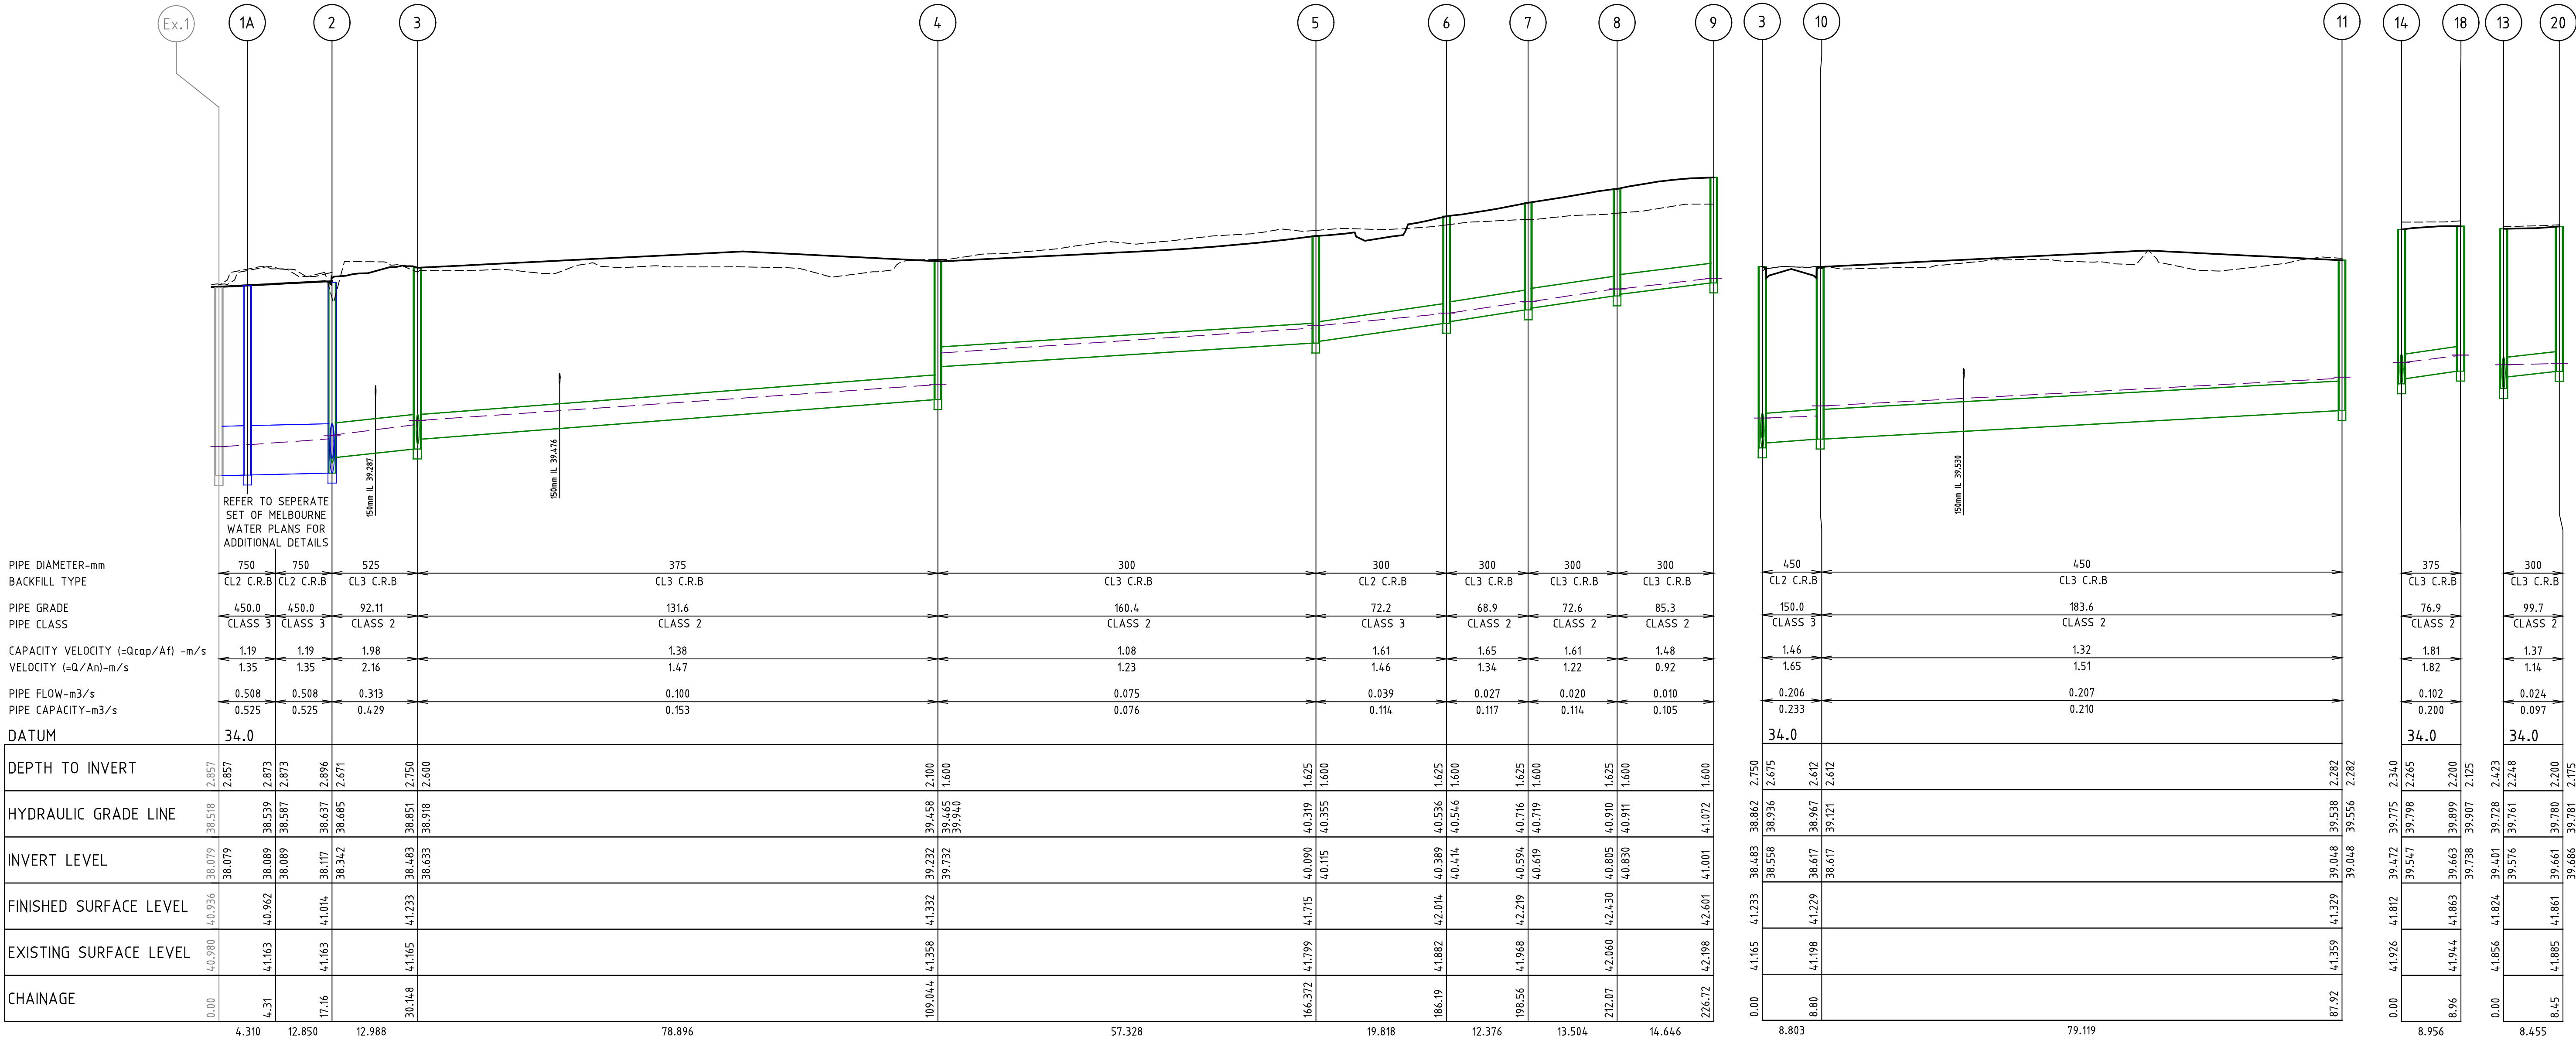

SIGN	DESCRIPTION	QUANTITY
 G9-20		1 No.
	STREET NAME SIGN DOUBLE	2 No.
 W5-10B W8-2B	 	2 No.



 TACTILE GROUND SURFACE INDICATORS (TGSi) BOTH DIRECTIONAL AND WARNING TO BE INSTALLED AT PRAM CROSSING LOCATIONS IN ACCORDANCE WITH AS1428.4

DISCLAIMER:
THESE DRAWINGS ARE TO BE USED ONLY FOR THE PURPOSE FOR WHICH THEY WERE
INTENDED FOR. NO RESPONSIBILITY WILL BE BORNE BY THE ENGINEERING CONSULTANT
SHOULD THESE DRAWINGS BE USED FOR ANY OTHER PURPOSE.

NOTES

1. RRPM'S ARE TO BE WHITE AND AT MAX 6m SPACING.
2. LINEMARKING TO BE EXTENDED AT LEAST 6m FROM THE TANGENT POINT
3. LINEMARKING IN ACCORDANCE WITH AS1742.
4. TGS1 TO BE INSTALLED IN ACCORDANCE WITH VICROADS RDN 06-06 - JULY 2010
5. ALL STREET NAME SIGNS AT INTERSECTIONS TO INCLUDE RELEVANT STREET NUMBERING.
6. ALL LINE MARKING PAINT SHALL BE LONG LIFE TYPE. LATERAL WORKS AND ARROWS BEING COLD APPLIED PLASTIC TROWELLED INTO PLACE (MATERIAL DEGADUR PLASTELINE) AND LONGITUDINAL LINES BEING EXTRUDED THERMOPLASTIC MATERIAL.

H 1 : 1000 0 10 20 40 60 80
@ A1

AS CONSTRUCTED

[illegible]